

Angle left

66°39'

454.5  
 96.3  
 575°26'W  
 542°24'W  
 571.1 W 64.9

⊙ +96.2  
 +50  
 62

Cor. No 28

Angle Right

24°35'

54.5  
 517.49 W  
 580.7 W 25.9

⊙ +99.9  
 +75  
 +50  
 +25  
 +40  
 +38  
 +30  
 +28

Cor. No 27

Angle Right

19°31'

44.5  
 514.2 E

⊙ +20  
 +15.1  
 +10  
 61

Cor. No 26

539. E 1.1

Angle Right


15°38'

99.57  
 515°42'W  
 517.26 E

⊙ +70.6  
 +50  
 +25  
 60

Cor. No 25

(9)

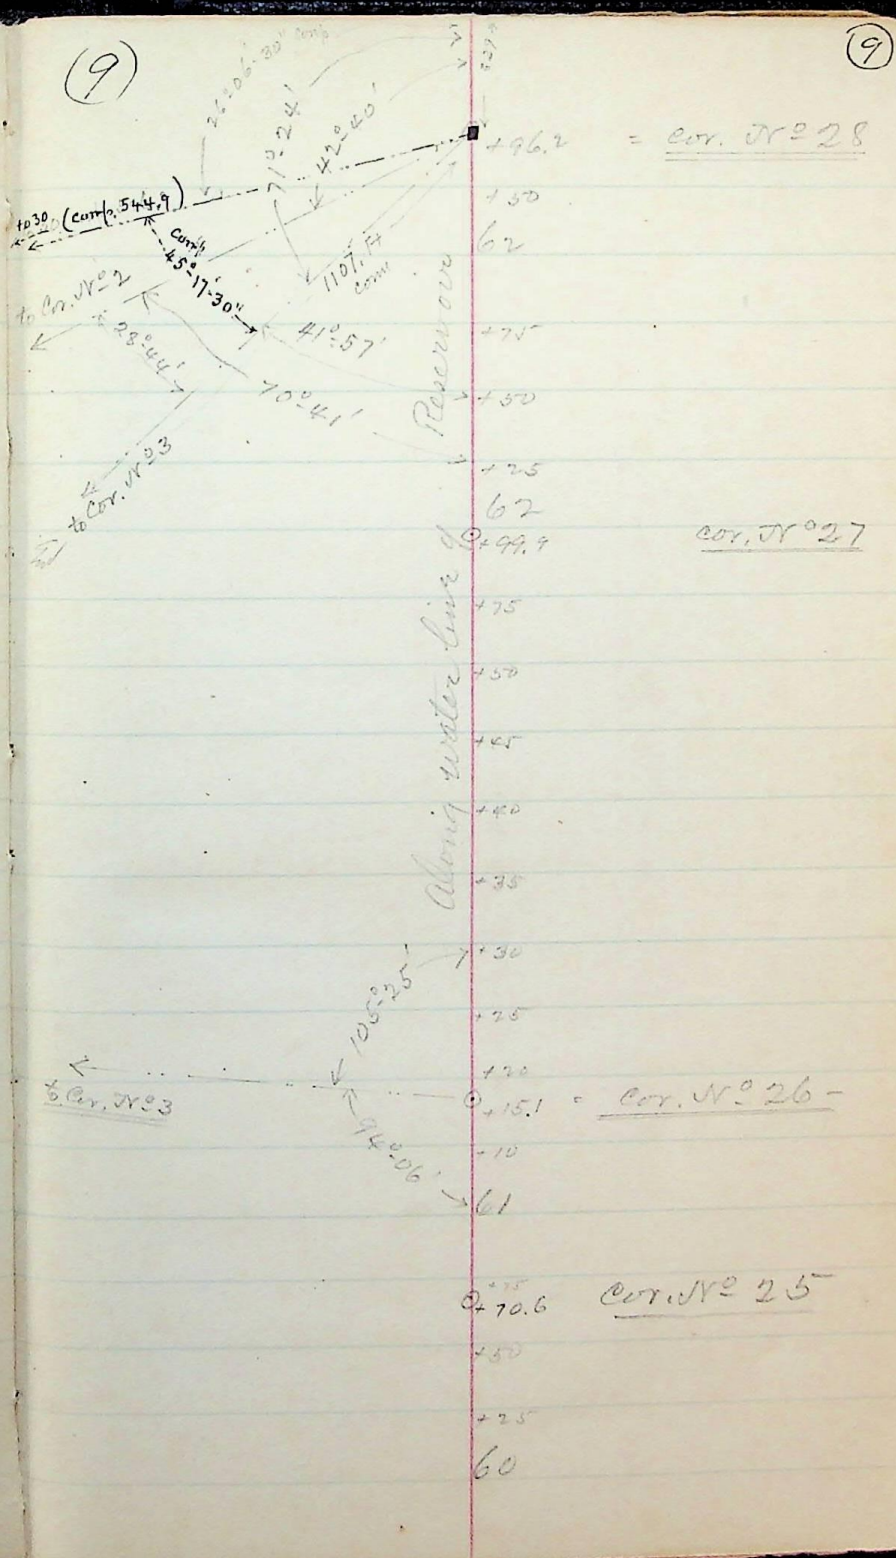

+96.2 = Cor. No 28

⊙ +99.9 = Cor. No 27

⊙ +15.1 = Cor. No 26

⊙ +70.6 = Cor. No 25

3  
0  
3  
9  
4  
7  
0