





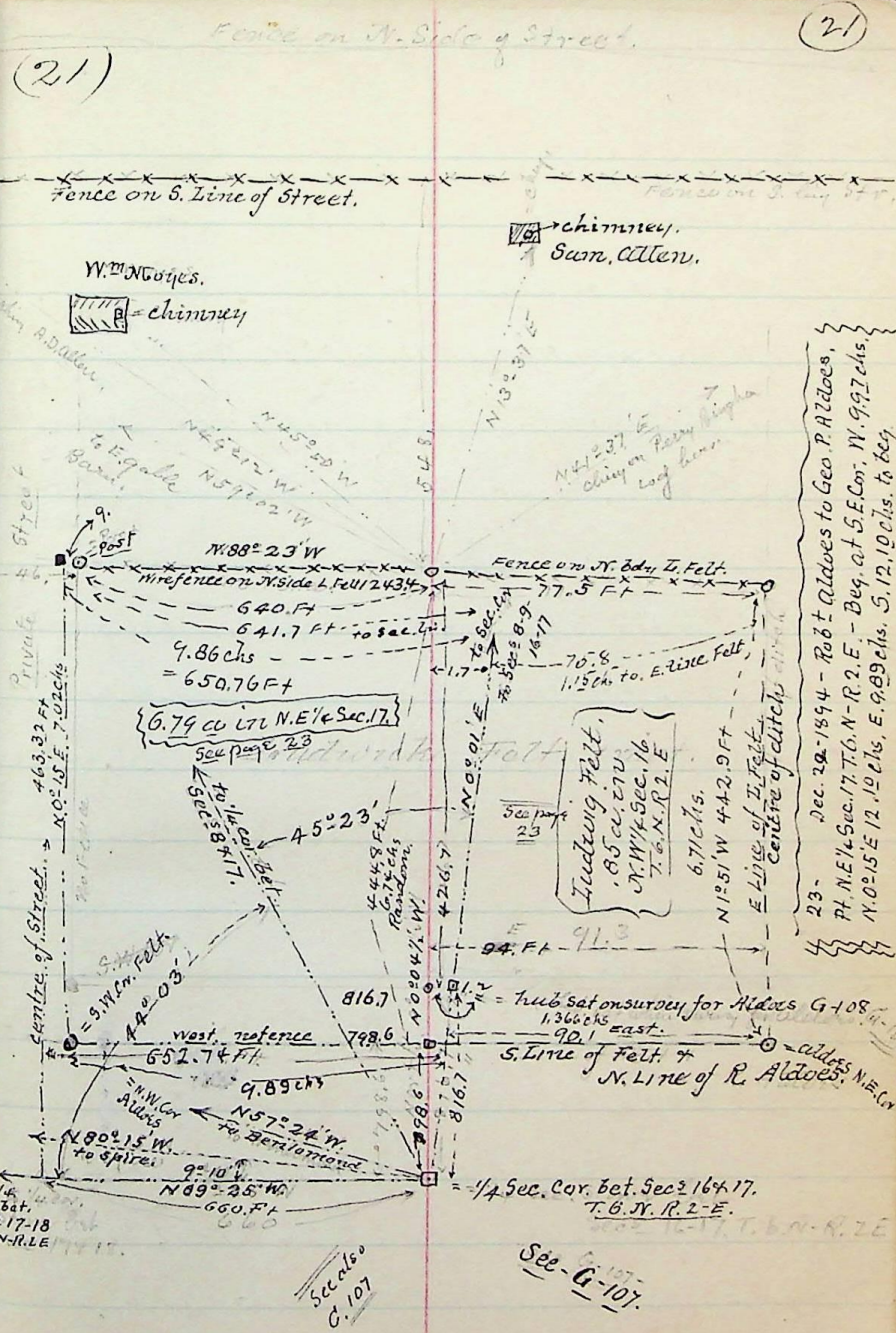

1/4 Sec. 17-18  
T.6, N. R. 2, E.

Sec also  
G-107

Sec-  
G-107


