2-453. C. Henry Barrett to Chas F. Wade. Pt. N.E¼ 30
T.7.N-R.1.W. Beg. 31.40 chs W. of N.E. cor. sd ¼
S 14¼° W 7.39 chs to pt. S 77° E. 5.05 chs m.
St. N 7.91 chs N 82°-56' W. 3.14 chs to beg.

2-525 C. Henry Barrett to Geo. S. Dean – Beg 11.75
chs N. of N.E. Cor. N.E¼ Sec. 30. T. 7. N-R. 1. W.
11.19.65 chs S 82°-56' W. 3.14 ch. S 7.91 ch.
S 77° E. 15.05 chs N 5½° E. 7.35 chs
N 10½° E 4.50 chs to beg

6-533 Dean to Sanford – B-526.

22-452 C. Henry Barrett to F. T. Sanford – Beg
11.75 chs N. of N.E. Cor. NE¼ Sec. 30. T. 7. N-R. 1. W
11.19.65 chs S 82°-56' E 3.14 chs S 7.91 chs
S 77° E 15.05 chs N 5½° E 7.35 chs N 10½° E
4.50 chs to beg. to correct 2-522 & 6-533,

M.E. Malone. Evanston Way.

see Mr Hunter. and deeds of land adjoining Malone tract

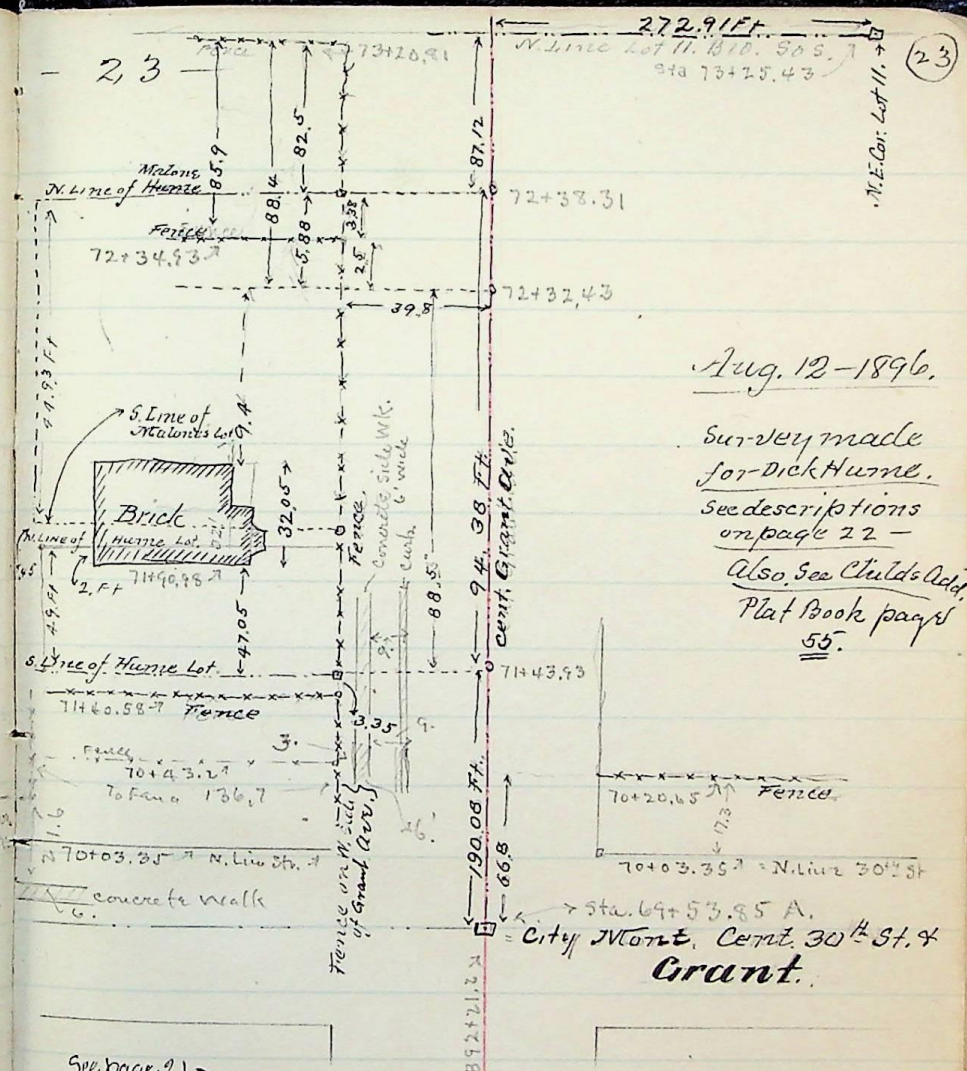

Aug. 12–1896.

Survey made for Dick Hume.
See descriptions on page 22 –
Also See Childs Add. Plat Book page 55.

See page 21 –

Description of Ludwig Felt's land in N.E¼ Sec. 17. Tp. 6. N.R. 2. E. – Beg. 12.10 chs N. of S.E. Cor. Sd ¼ Sec, Running thence N. 6.74/100 chs. along Sec. line, thence N. 88°-23' W. 9.86 chs. thence S. 0°-15' W. 7.02 chs, to point W. of beg, thence E. 9.89 chs. to beg, 6.79 ac.

See page same page 21 –

Description of Ludwig Felt's land in N.W¼ Sec. 16. T. 6 N – R. 2 E. Beg. 12.10 chs. N. of S.W. Cor. said ¼ Sec, thence N. 6.74 chs. along Sec. line, thence S 88°-23' E. 1.15 chs, thence S 1°-51' E. 6.71 chs, to point E. of beg. thence W. 1.366/1000 chs, to the place of beg. 85/100 a.

Deeds written by self Oct 31-1896.