O-98 Alonzo Knight to Emma E. Snyder.

Pt N.W¼ Sec. 3. T. 6. N-R. 2. W. Beg. 110.3 rods

S. of Sq. 58. rods W. from N.E. cor. sd ¼ N.

24 rods N. 40.4 rods S. 89¼° E. 30.4 rods

S. 7¾° W. 40.5 rods to beg. 6¾ a.

1-286. U.S. Pat. to Hans C. Hanson—

All. N.W¼ Sec. 3. T. 6. N-R. 2. W.

17-111. Hans C. Hanson to John Wood.

Pt N.W¼ 3. T. 6. N-R. 2. W. - Beg. 38 rods E. of

N.W. Cor. sd ¼ E. 20.7 rods. S. 112. rods

W. 20.7 rods N. 112. rods to beg.

Aug. 24th 1896.
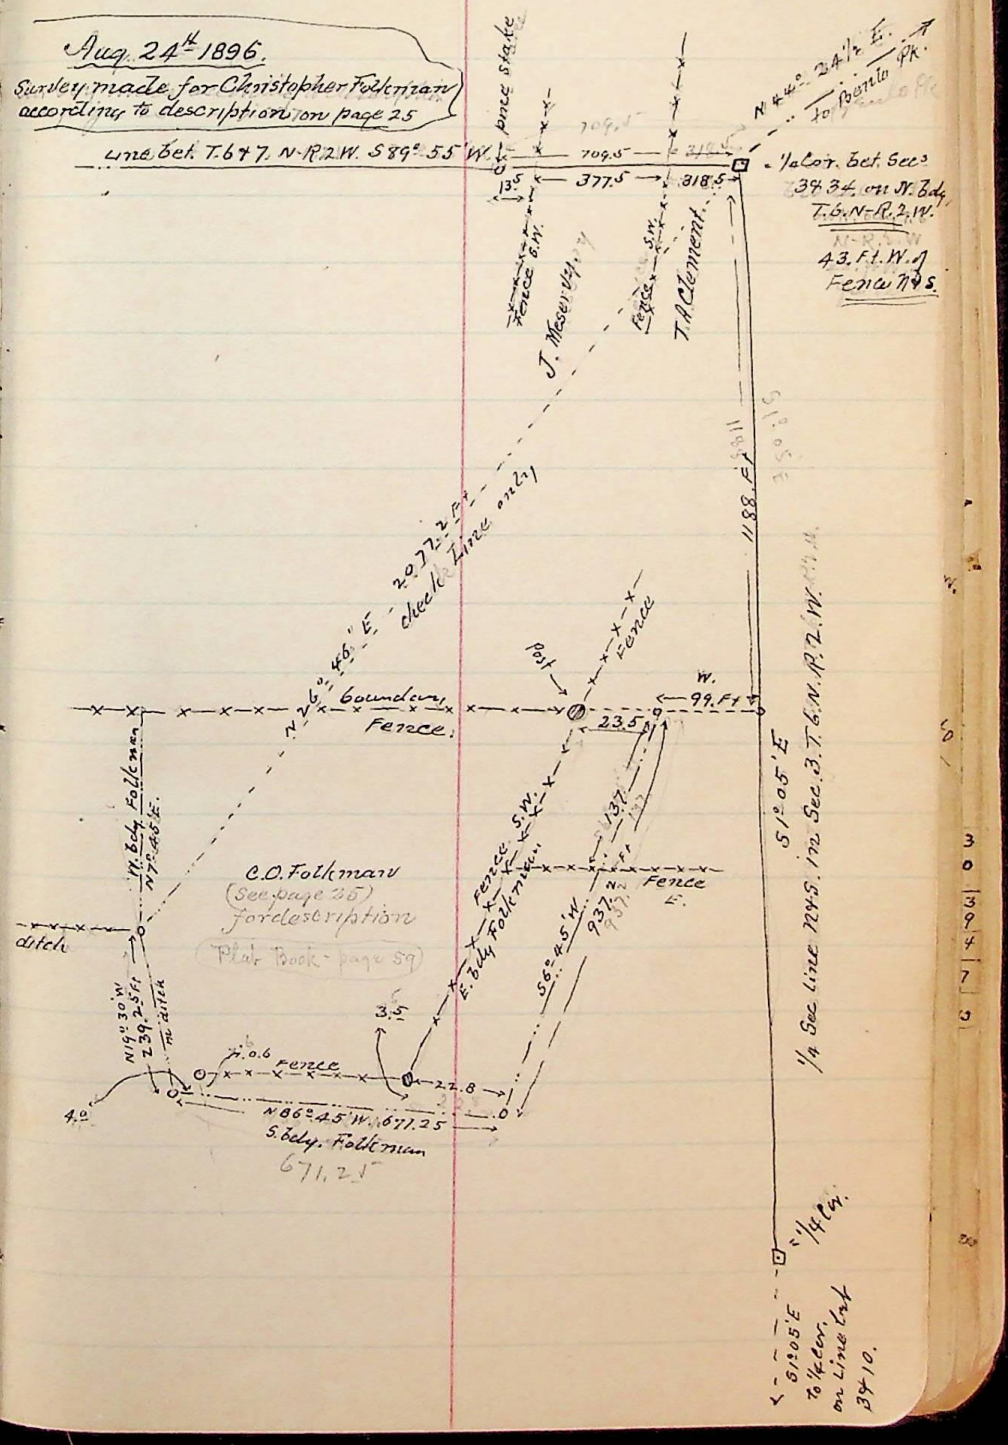
Survey made for Christopher Folkmann according to description on page 25