September 7th 1896.

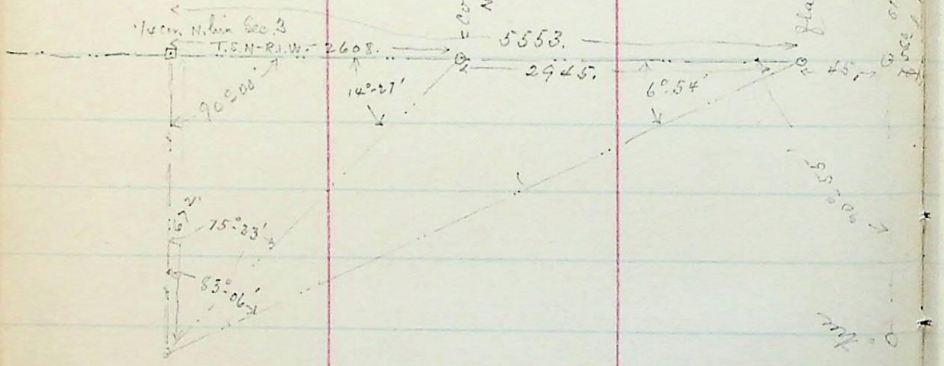

sin 6°54'	9.079676	log sin 14°21'	9.397132
sc " "	0.992324	sd "	0.802868
sin 83-06	9.996843	log " 75-33	9.986039
log 672.	2.827369	672	2.827369
5553.	3.744536	2608.	3.416276

5553.
2608
2945.
2608
337.

Sept. 7- 1896.

Survey made for T. Matan on Sec. 2, T. 5 N. R. 1 W. U. S.

I beg. at 1/4 Sec. Cor. on N. line Sec. 3, which is a stone marked 1/4, in mound of stone. I triangulate dist. to flag at E top of ridge and find dist to be 5553. feet, and on same line is Cor. of Secs 2 & 3 on N. bdy of Sp. I also triangulate dist to post at Cor of Secs 2-3 on N. bdy Sp & find dist to be 2608. ft. Therefore the flag is 2945. feet E. of the Cor. of Secs 2 & 3. 305. ft E. of the position for the 1/4 cor. which is inaccessible on acct of cliffs. From Sta 2945. I measure dist. 2990. I set tub. on crest of ridge & run 2 chs bearings S 20° E. & N. 20° W. on ridge S. of Cañon bears S. N., Falls of Waterfall Cañon bear S. about 15.00 chs dist. Thence over ground Sloping S. into N. F. Cañon

3046.6
3046.6 set tub. Obst. Pk. bears S 81° 54' E thence over ground sloping S.

4328.6 70° 70° wagon road S. E & N. W.

5280. Find no trace of old cor. Set temp. cor. to Secs 1-2 an oak 6 take, in thick brush, Find bears after blazing trees & brush in vicinity.