Chesterfield Idaho
Nov. 10-1896.

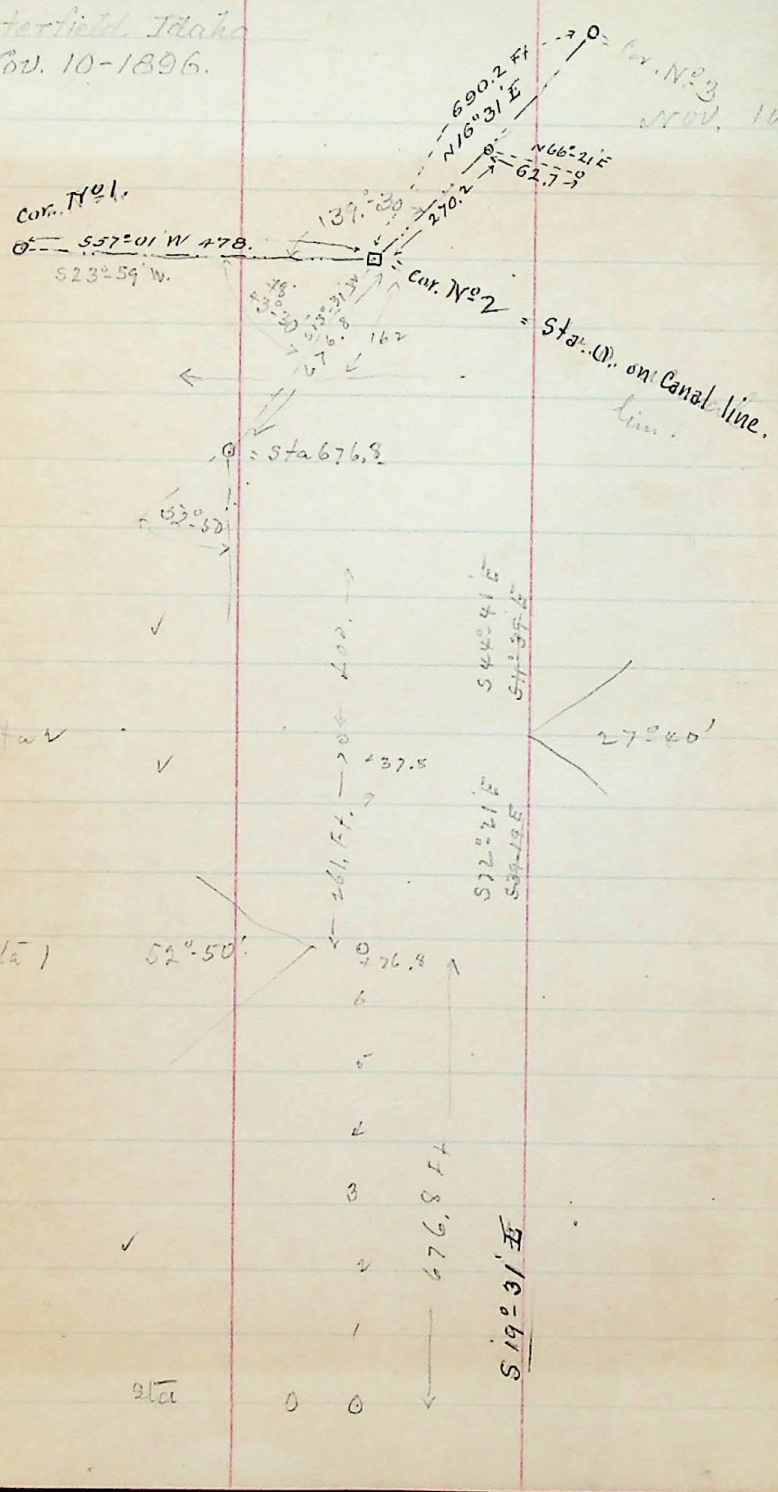

(48)

Meanders of the North Branch of the Chesterfield Canal. Beginning at Cor. N° 2 on the reservoir and meander main Channel of 2A Mile Cr. to Head Gate
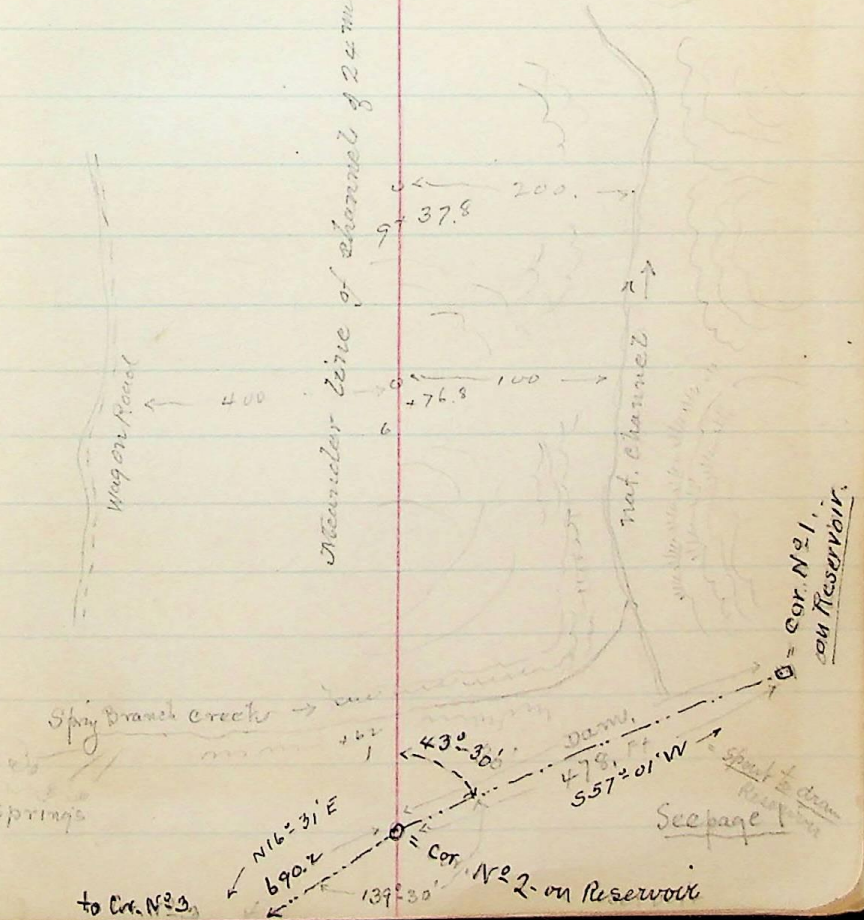
(48)