


West.
 H. or W. Branch Canal, 4 Ft. wide
 & 3 Ft. deep.

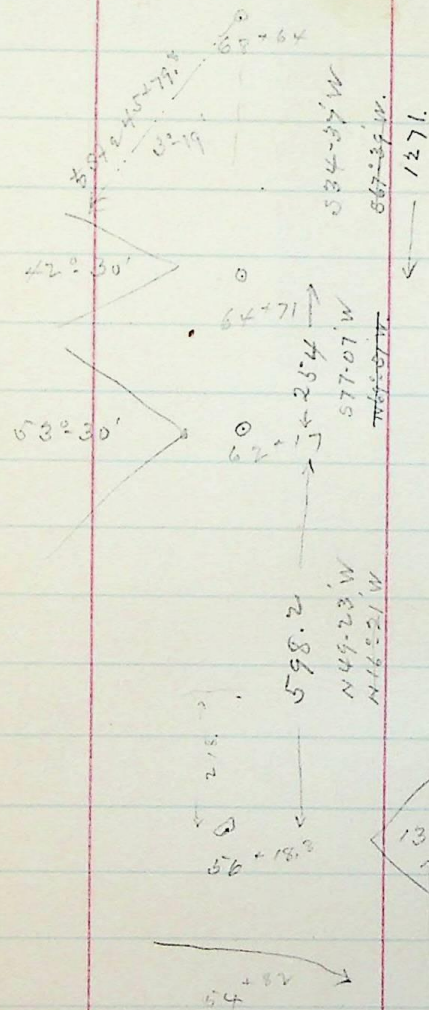

mag S 25° 30' E

50 + 19



1039

S 7° 20' E

S 23° 37' W

4281.

(51)

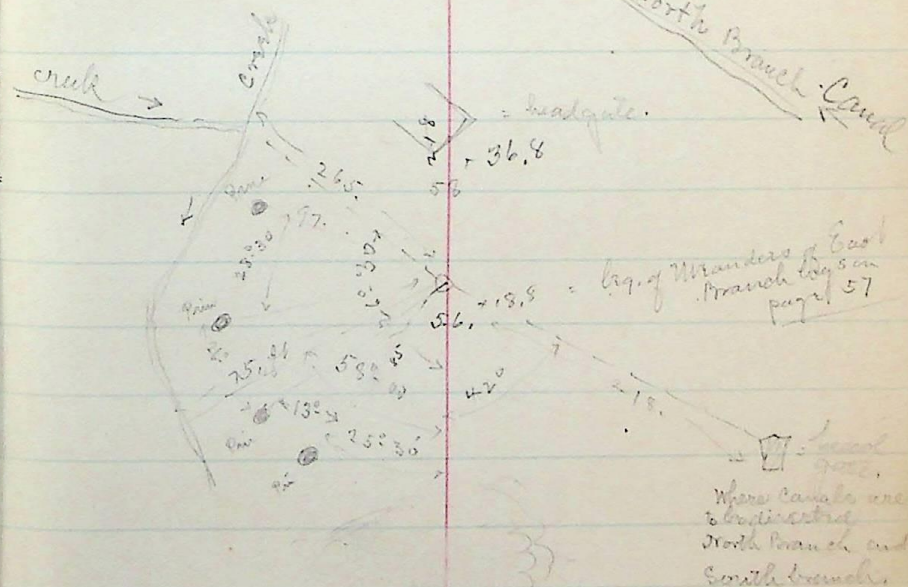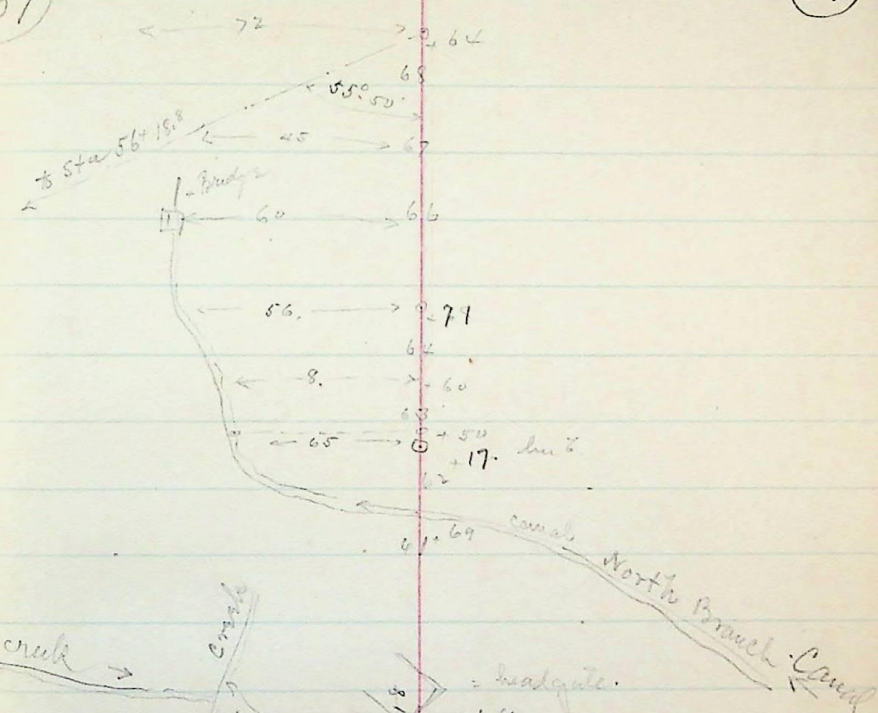

Where Canals are
 & head gates
 North Branch and
 South Branch.

Branch creek
 50 + 59