


South or West Branch Canal.

Nov 11-1896

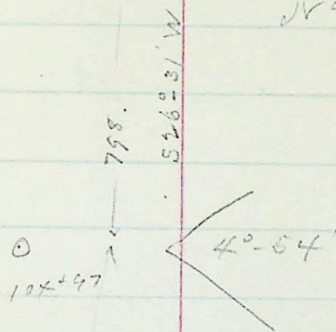

mag 5200 W.

1912. Ft

521° 37' W

554° 39' W

(53)

(53)

