


North of W. Branch Canal.

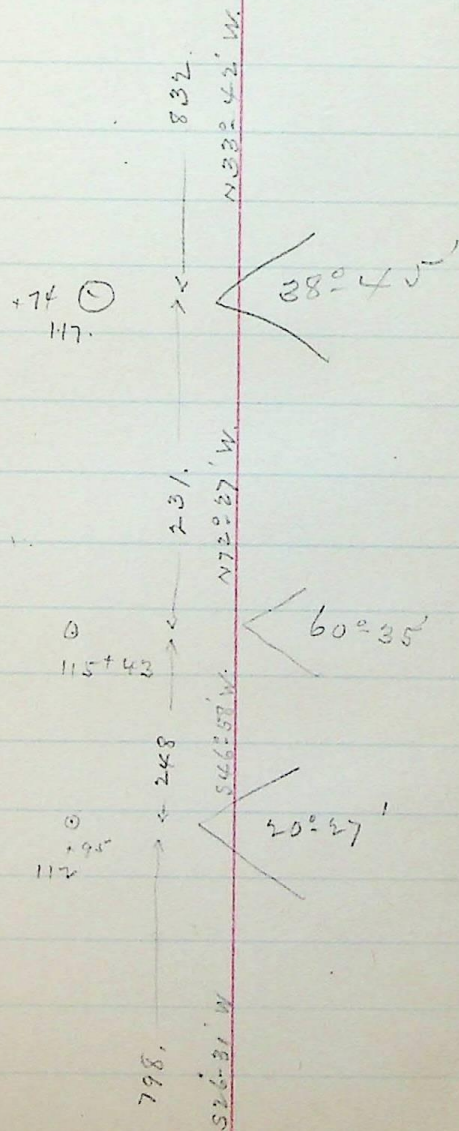

(54)

(54)

