


North or W. Branch Canal.

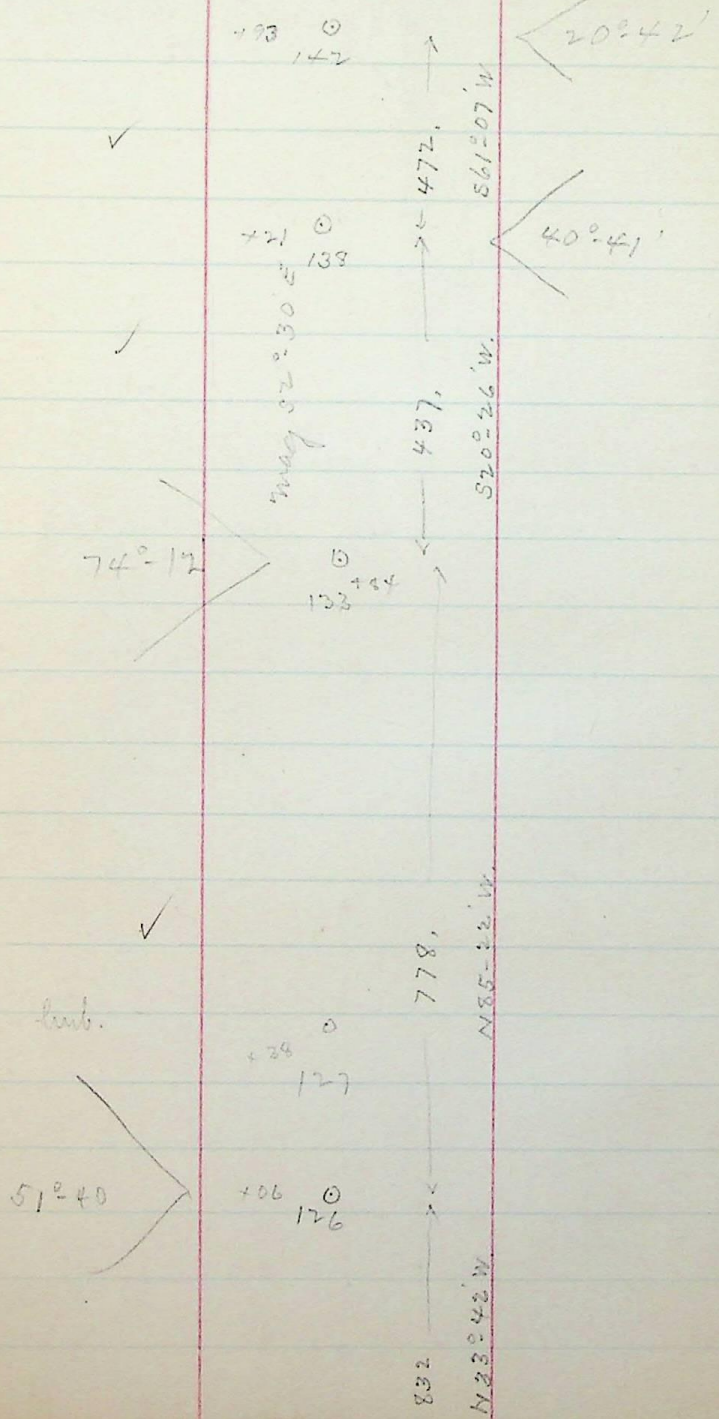

(55)

