


East Branch Canal

3,51-855' long

539°42' E 989'

Nov. 12-1896

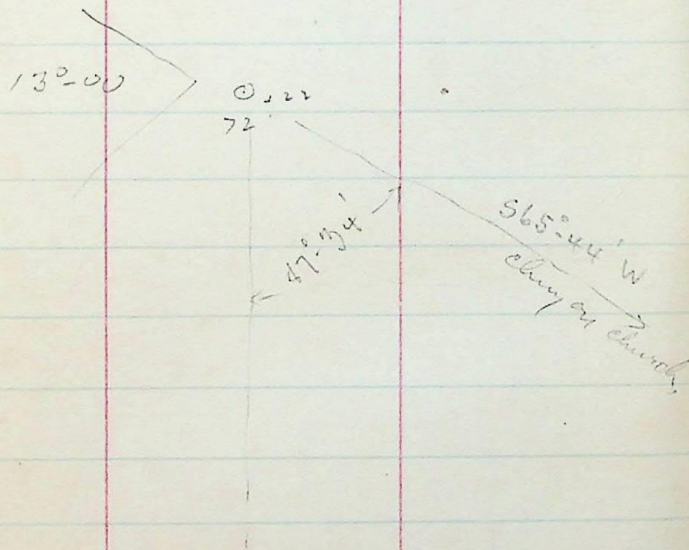

3,002-775' long

526°22' E 1399'

(60)

