


East Branch Canal

Nov. 12-1896



(61)

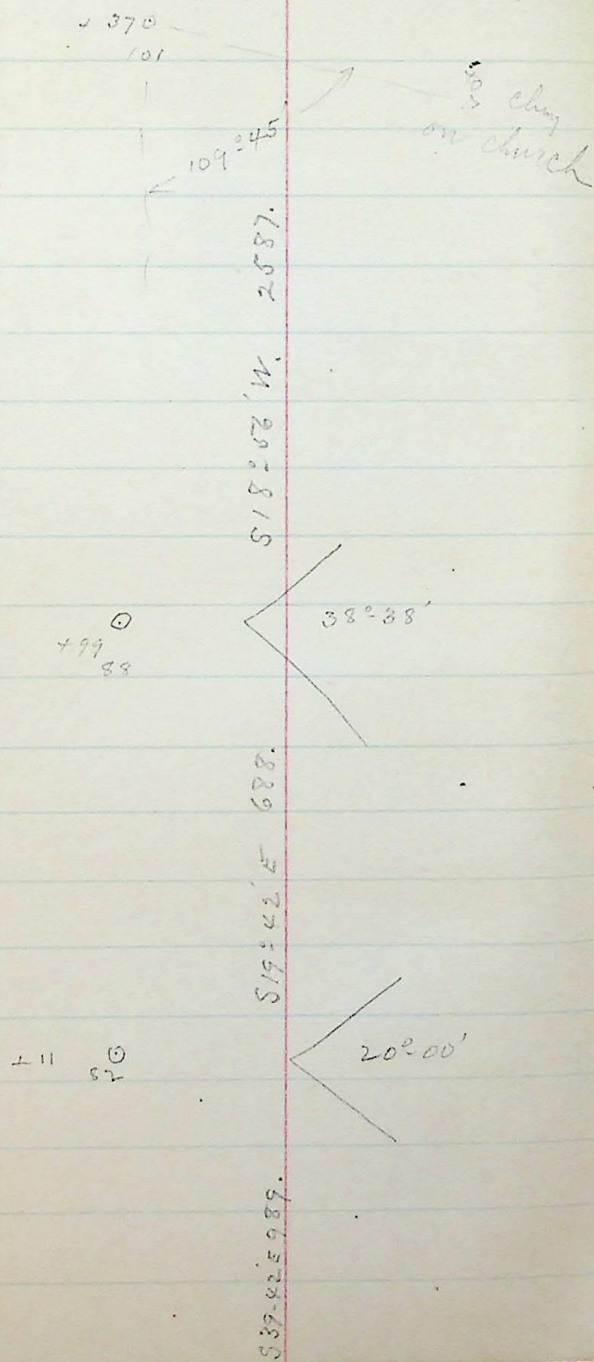