


East Branch Canal.

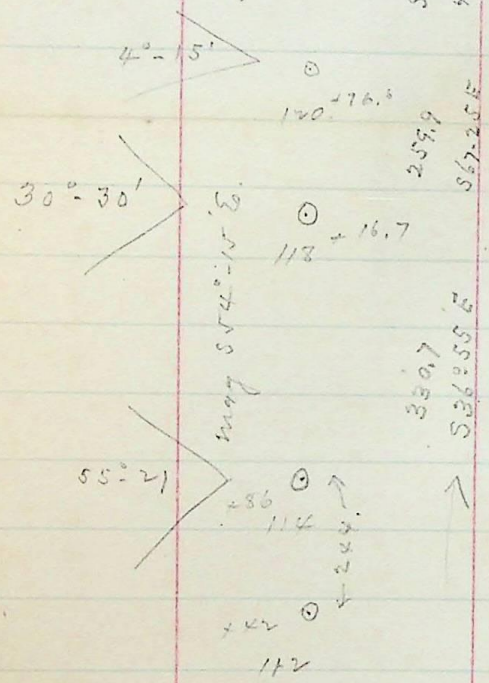

hub.

hub.

+ 79.5  
109

28-52 N, 25=815


(2)

(62)

Station

No. 10

2017

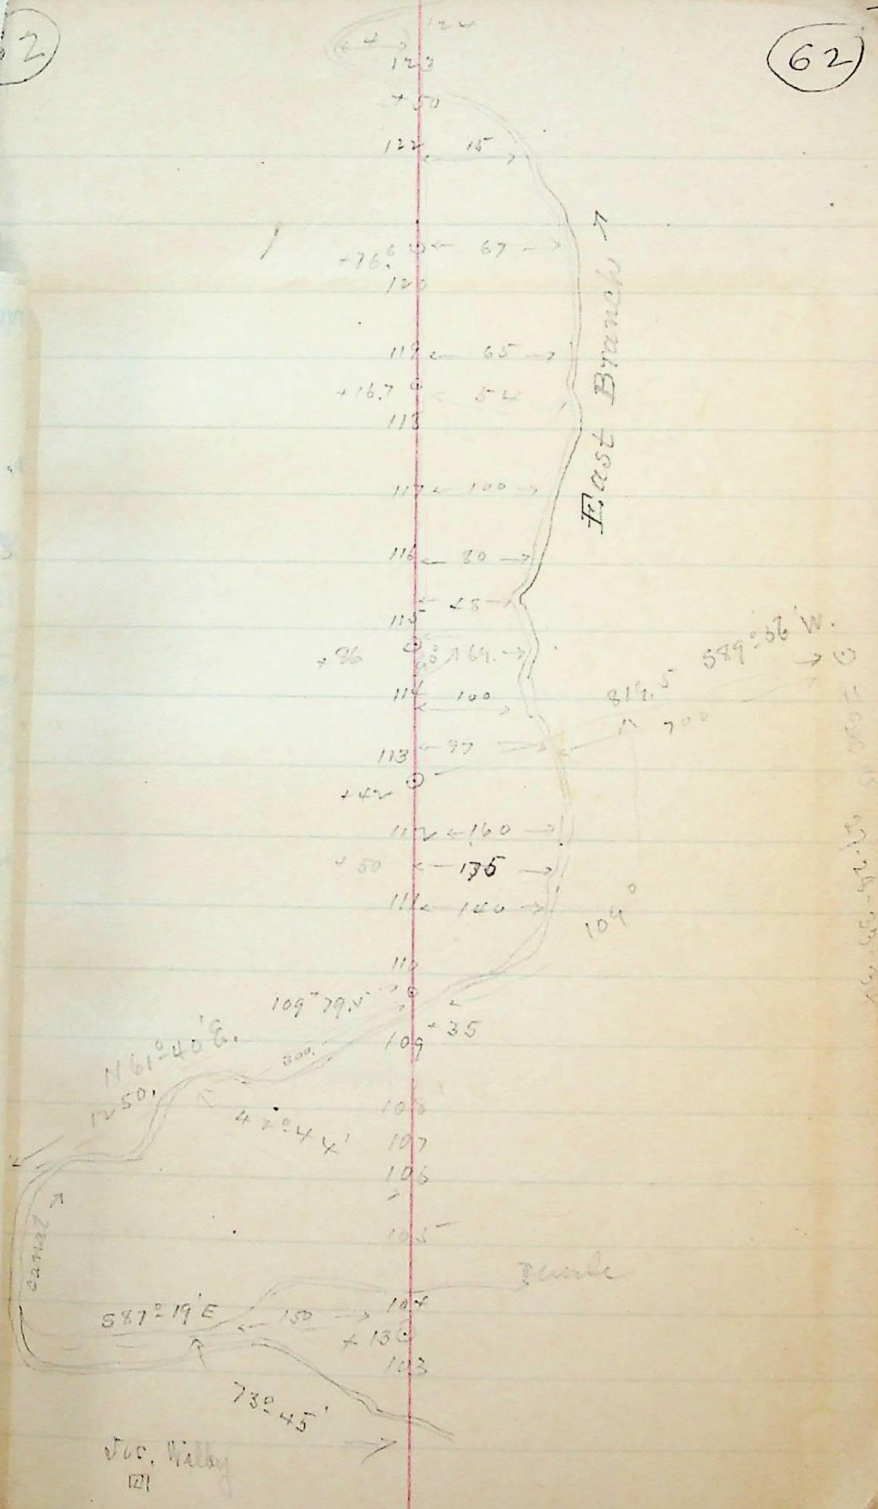

Joc. Wilby  
121