Nov. 18-1896.

Re-measurements made in Surv. of Sec. 36. T. 7. N. R. 2. W. for Harvey Murdock & Thomas Brown, & others.

See pages - 42. to 46. this book.

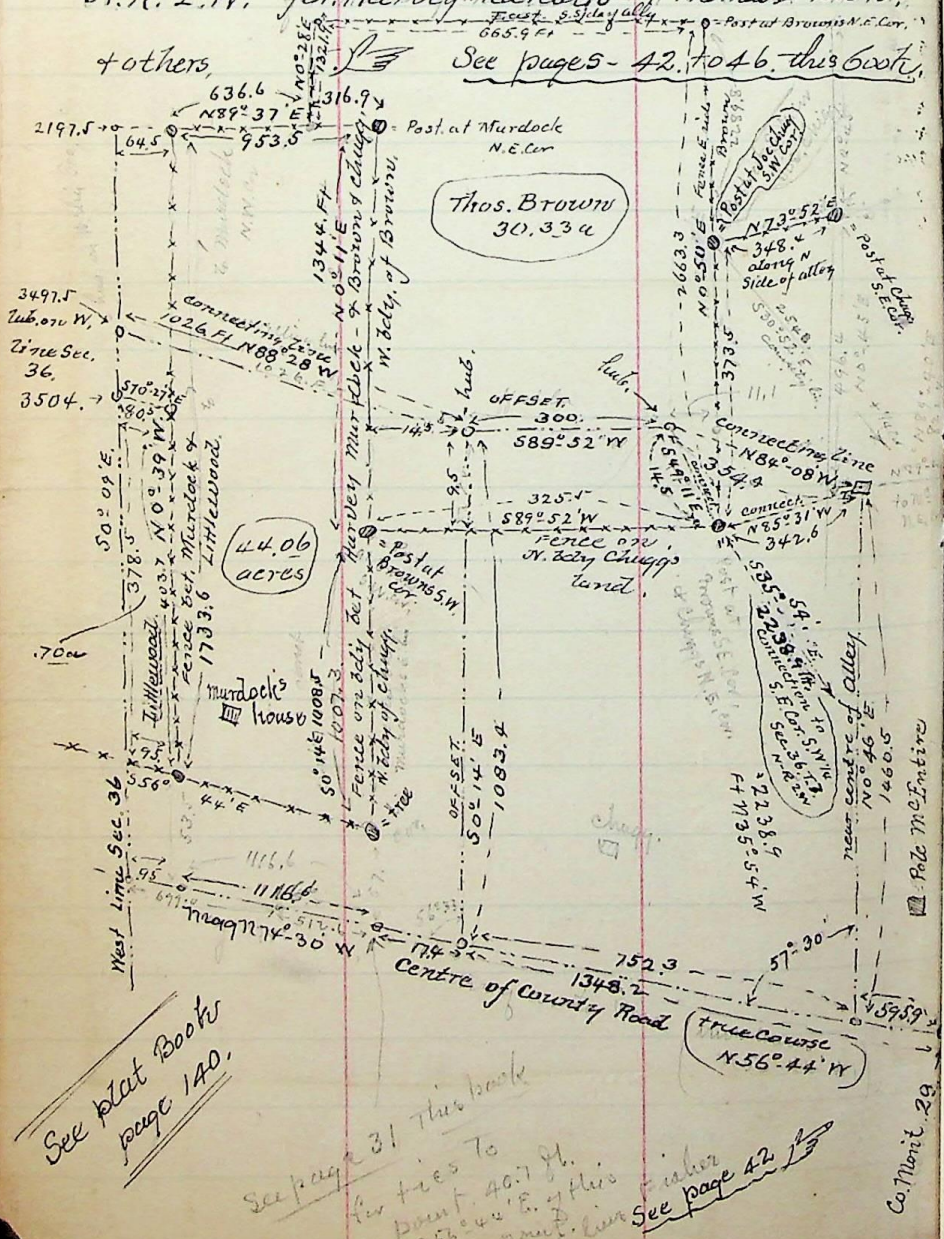

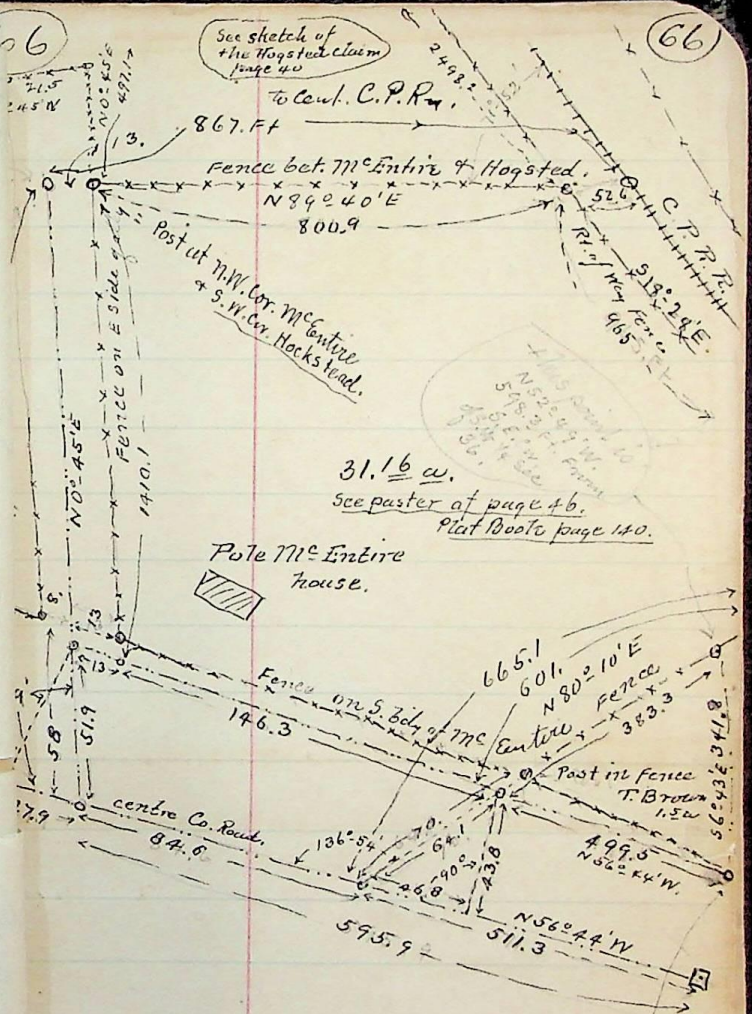

T.D. Brown. Pt. Sec. 36 T. 7. N. R. 2. W. – Beg. at pnt. N 35°54' W. 2238.9 ft dist. from S.E. Cor. S.W¼ Sec. & Sec. – Thence S 89°52' W. 325.5 ft. N 0°-11' E. 1344. Ft. S 89°-37' W. 316.9 ft. N 0°-28' E 1321.4 Ft. to S. Side of alley. Thence E 665.9 ft on S. Side alley. S 0°-50' W. 2663.3 ft to beg. 36.33 a

Description of T.D. Browns tract. Mont Co.

Road in S.W¼ Sec. 36. T. 7. N. R. 2. W. –

(2) Beg. at point 437.3 Ft. N 87°-05' W. from S.E. Cor. S.W¼ Said Sec. on W. line Co. Road. Thence N 6°-43' W. 341.8 ft. – S 80°-10' W 383.3 ft. to N. line of Co. Road. thence S 56°-44' E. 499.5 ft along N. line of Co. Road to beg. 1.5 a.

Also. Beg. on S. line of said Sec. 592.1 ft N 89°-33' W. from the

(3) S.E. Cor. of S.W¼ of Said. Sec. 36. and on S. side of County Road, thence N 39°-33' W. 699.5 ft along Sec. line. – N 42°-30' W 10.5 ft N 13° E. 401.4 ft. to S. Side of Co. road. thence S 56°-44' E 737. Ft. along S. side of road to beg. 3.25 a. = 35.08 a

For description of 14.79 a. tract see paster. (43)