Nov. 23-1896 Traver

Survey made in Sec. 16, T. 6 N-R. 2 W. For Hadley T. 6 N

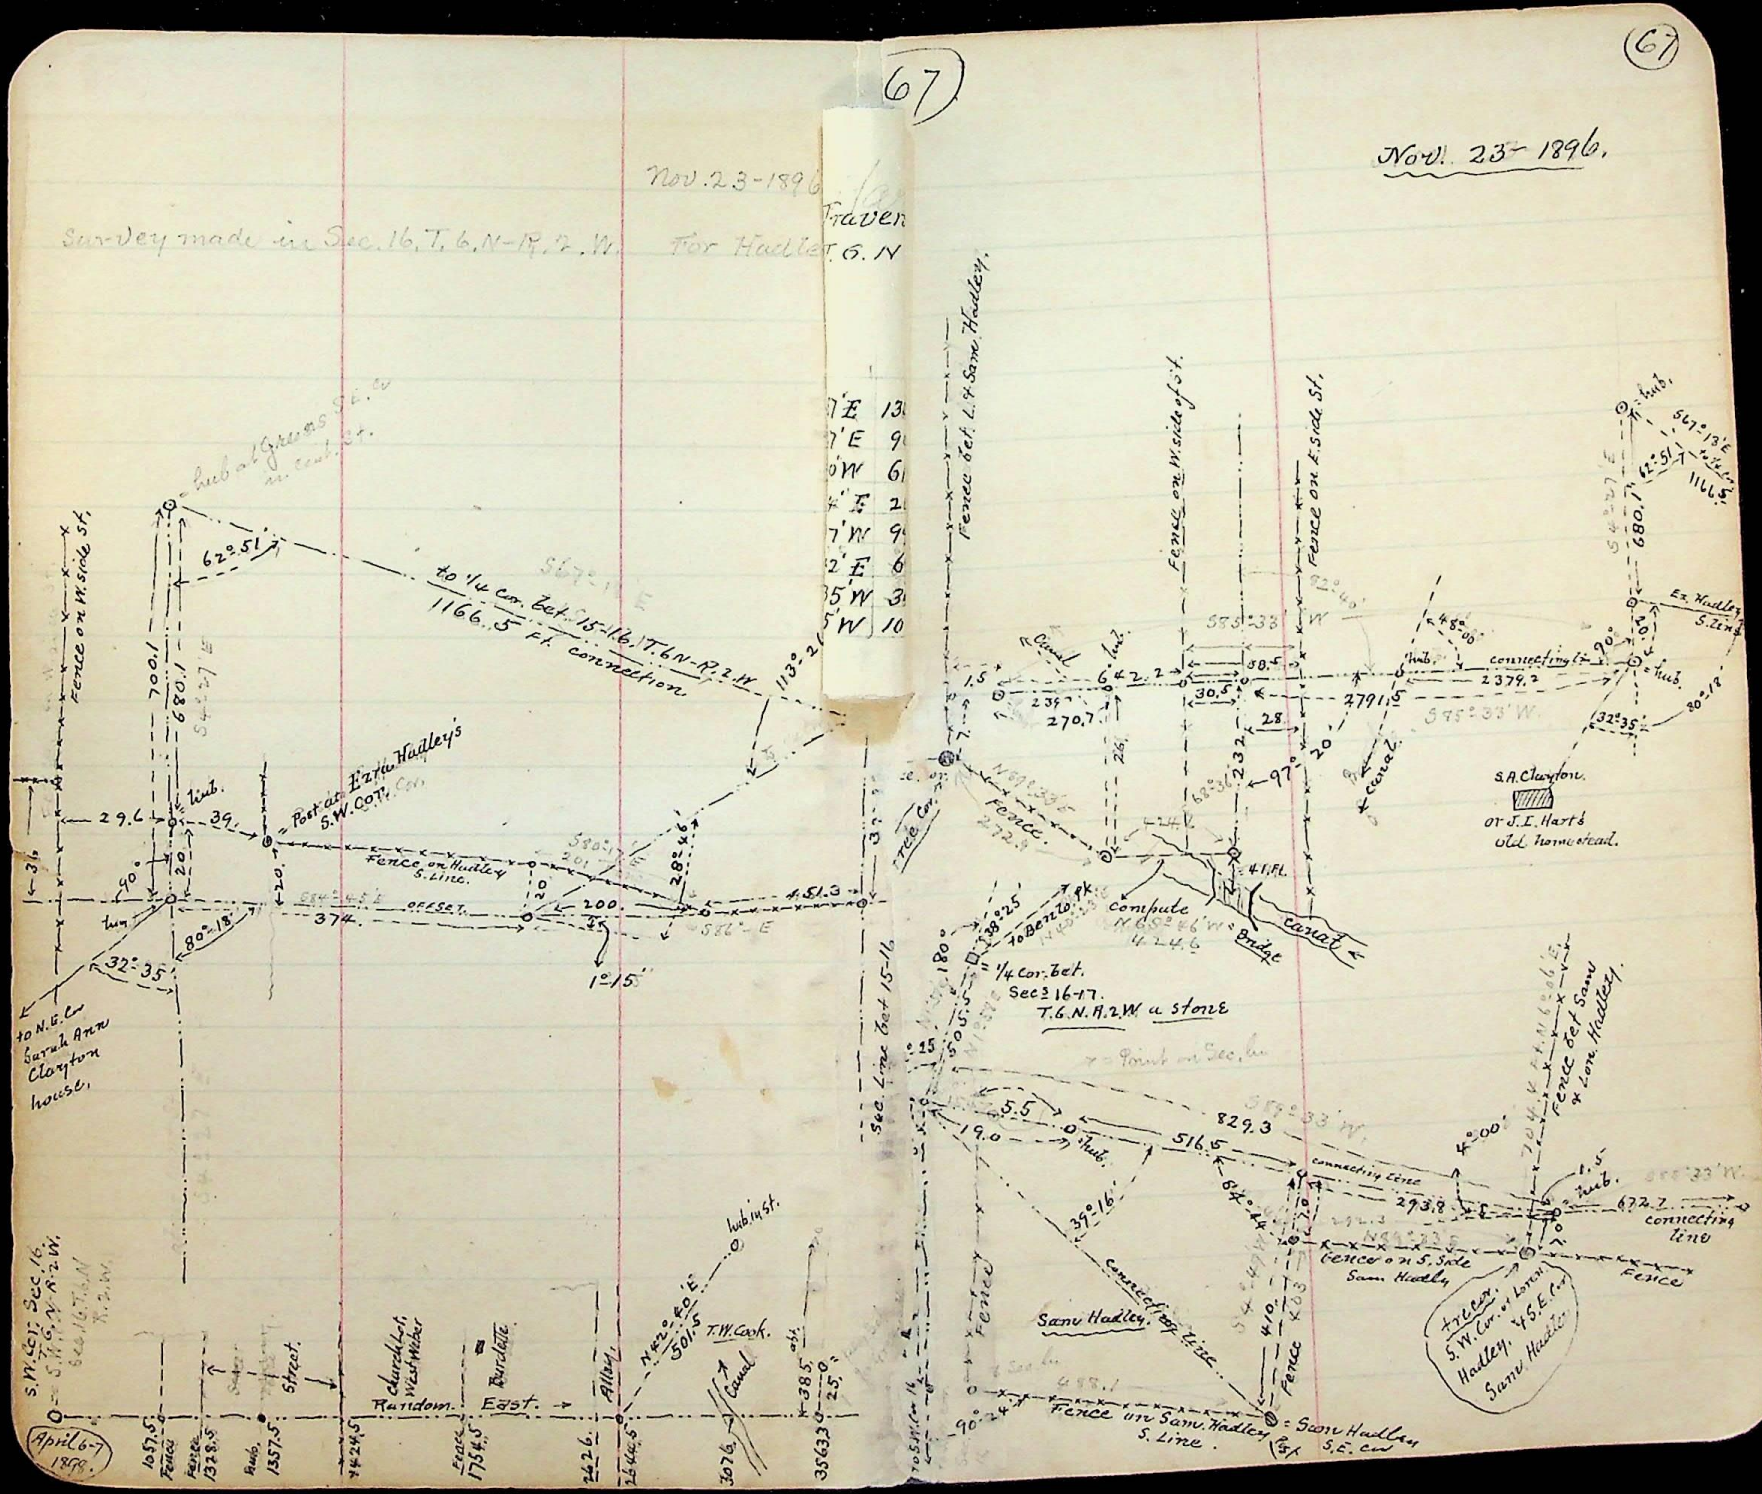
Nov. 23- 1896.
Sub at grass Sta. on east st.
Fence on W. side St.
62° 51'
to 1/4 cor. bet. 15-16, T. 6 N-R. 2 W.
1166.5 ft. connection
700.1
680.1
29.6
39.
Tub.
Post at Eliza Hadley's S.W. Cor.
Fence on Hadley S. Line.
20.
28.4
451.3
374.
offset
200.
1° 15'
90°
80° 18'
32° 35'
to N.E. cor Sarah Ann Clayton house.
Fence bet L. 4 Sam. Hadley.
Fence on W. side of St.
Fence on E. side St.
Canal
Tree Cor.
Fence
N 89° 36' W
272.8
compute
N 88° 46' W
424.6
41. Ft.
Bridge
Canal
10 Beech
38° 25'
1/4 cor. bet. Sec. 16-17. T. 6 N. R. 2 W. u stone
Sec. Line bet 15-16
Point on Sec. line
500.5
180°
15
5.5
19.0
Tub.
829.3
516.5
connecting line
4° 00'
35° 16'
Tub 14 St.
N 42° 40' E
501.5
T. W. Cook.
Canal
Fence
Sam Hadley.
connecting line
Fence on S. Side Sam Hadley
Fence
Fence bet Sam & Lon. Hadley.
S. M. cor. Sec. 16 T. 6 N. R. 2 W.
Random.
East.
Alley.
Church-Lot West Water Street.
1057.5
1328.5
1357.5
1734.5
2626.
2644.5
3076.
3563.3
Fence
Fence
Fence
Fence
Tub.
Tub.
Tub.