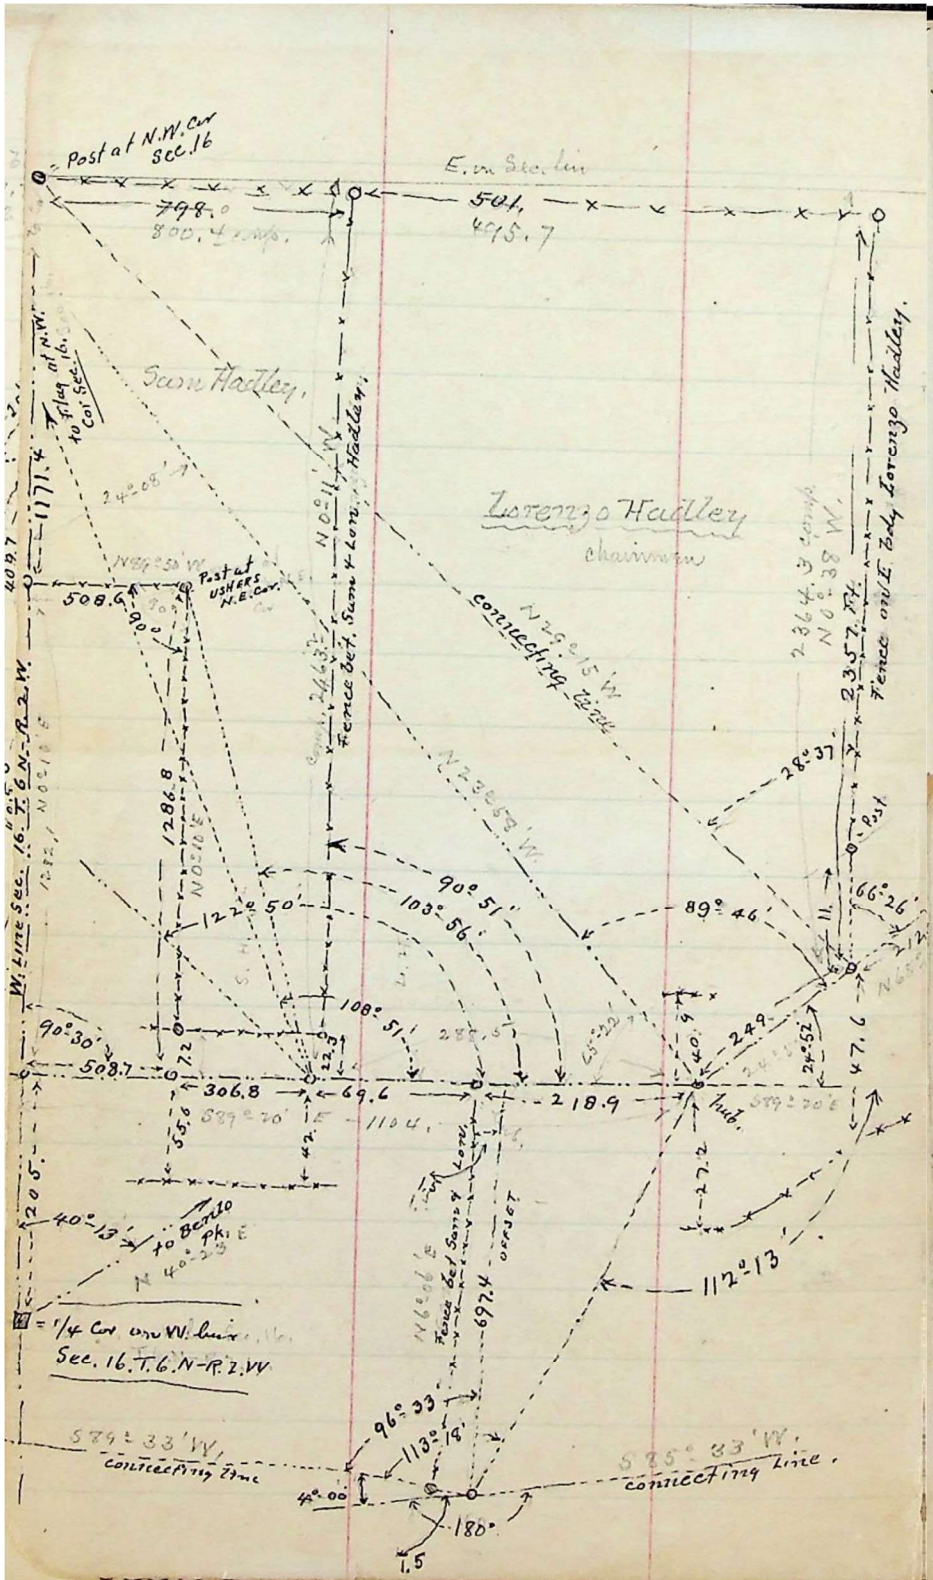
Post at N.W. Cor Sec. 16
E. on Sec. line
798.0
800.4 comp.
501.
495.7
Sam Hadley
Lorenzo Hadley
chainman
Post at USHERS N.E. Cor.
Fence bet. Sam & Lon. Hadley
connecting line
Fence on E. bdy Lorenzo Hadley
W. Line Sec. 16. T. 6 N - R. 2 W.
to Flag at N.W. Cor. Sec. 16
1171.4
508.6
1286.8
122° 50'
90° 51'
103° 56'
89° 46'
108° 51'
90° 30'
508.7
306.8
69.6
218.9
249
47.6
66° 26'
28° 37'
112° 13'
40° 13'
to Bento Pk.
= 1/4 Cor. on W. line Sec. 16. T. 6. N - R. 2. W.
S89° 33' W.
connecting line
96° 33'
113° 18'
180°
1.5
S85° 33' W.
connecting line.

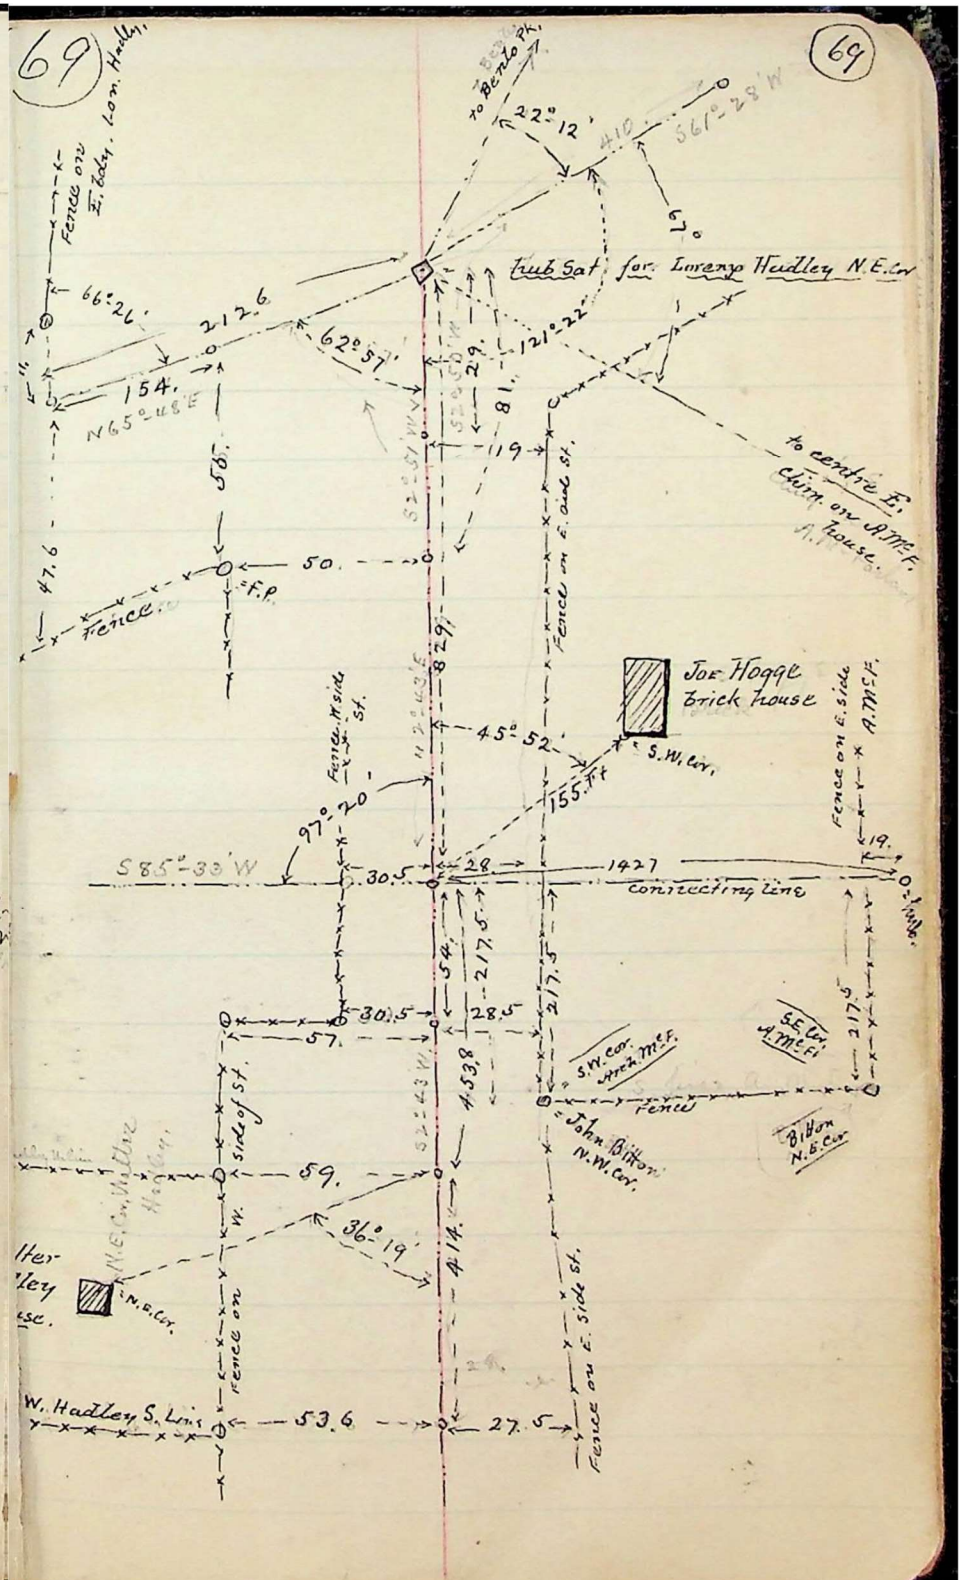
69
69
to Bento Pk.
22° 12'
S61° 28' W
67°
Fence on E. bdy. Lon. Hadley
Hub Sat for Lorenzo Hadley N.E. Cor
66° 26'
212.6
62° 57'
121° 22'
154.
N65° 48' E
to centre E. chim. on A.McF. house
50.
F.P.
Fence
Joe Hogge brick house
S.W. Cor.
45° 52'
155 Ft
97° 20'
S85° 33' W
30.5
28
1427
connecting line
Fence on E. side A.McF.
30.5
28.5
57.
S.W. Cor. Arch McF.
S.E. Cor. A.McF.
John Bitton N.W. Cor.
Bitton N.E. Cor.
59.
36° 19'
N.E. Cor.
W. Hadley S. Line
53.6
27.5
Fence on E. side St.