See Plat Book, pg. 132 - 144

Harrisville. November 25-1897.

Survey made for Wm Lakes & H.G. Taylor & Wm Louden Marcy Taylor

in Sec. 6. Tp. 6. N.R.I.W. Beg. at N 2.30 W, 17.38 E from S.E. cor. Sec 6. N on random Var. 4° E. 2451 ft, to p. 45.5 ft W. of fence N & S. and 88 ft E. of fence runs N. along P. Lakes E. line.

West 2784 ft. on a line 3 ft. S. of fence from the 2451 ft point to a point 23 ft S. of the old 1/4 cor. bear N39°36' W in Cent. Sec. add the 88 ft made a N. line of 2832 ft to which is 16 ft therefrom at 1368 ft a set 1/16 cor at 1762 ft Wm Lakes W. fence N45. nearly Therefore the E. line of 1/4 Sec. bears N 0°37' E 2451 ft

bearings N 0°30' W on E. line N.E. 1/4 Sec. 6. to a set S.E. cor. at 1312 ft. fence runs W along N. side of Harry G. Taylors clearing 1564 ft the N. line of Wm Louden's tract at 1135. set sub on fence line S 89°12' W 1137 + 13.5 to N. side of fence 98 ft fence

W. Louden. to N. end Box Elder ditch thence N 49° W. 200 ft along W. side of said ditch to N. side of road. all E. of this line being W. Louden's

S.W. Cor Sec 6

2140. Ex - - - - 2645.1

75

Nov. 29-1897.

Notes from Survey of Co. Road in Randall Dist. in Sec. 4. Tp. 6. N.R.I.W. near old res. of David Garner, See. Road Book notes, B page 33. (See also field-notes of Land surveys Book C. page 153.

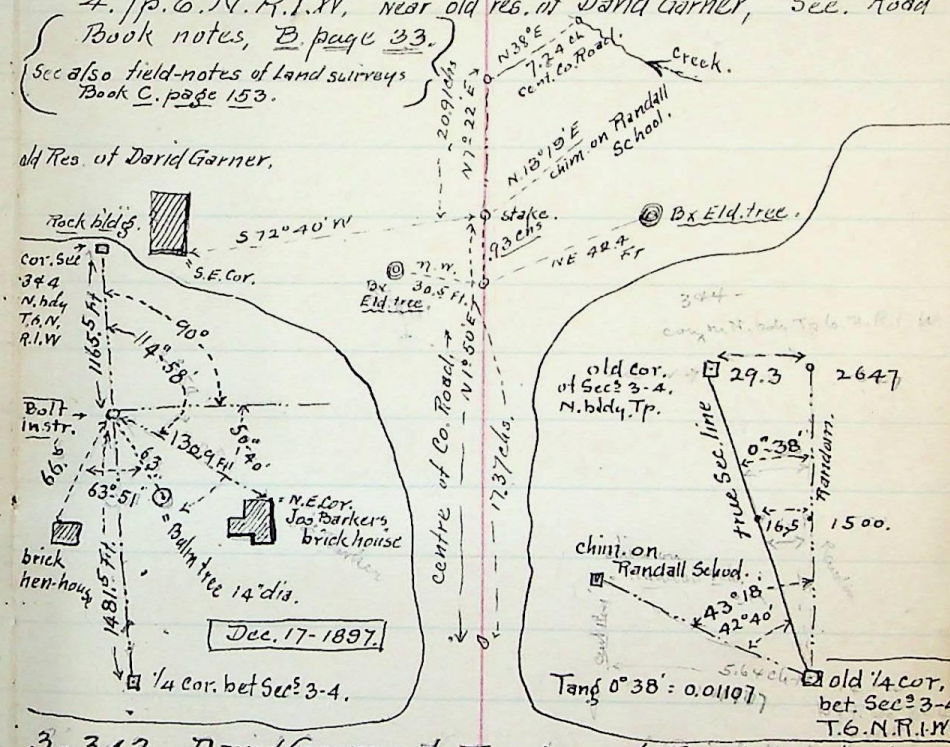

3-343. David Garner to Trustees of Randall School Dist. = ~~Beg 17.5 chs S. of N.W. cor of Sec 4 T. 6 N. R. I. W. S. 1° E. 7.50 chs N. 1° E. 7.50 chs~~ Beg 7 rods N. & 5 rods W. of S.E. cor. N.E. 1/4 Sec. 4. T. 6. N. Rg. 1. W. N. 13 rods. W. 13 rods S. 13 rods. E 13 rods to beg. ~~S.W. cor also in S. line of the Selinger.~~

11-404 Garners Est. to Frank & David Moore Beg. S.W. cor N.W. 1/4 Sec. 3. T. 6. N. R. 1. W. E. 20 chs N 20 chs W 17.79 ch S 4° 15' W. 3.179 chs S 86° 15' W 2.46 chs to N. line Sec. 3 S 4.67 chs to pt 12 chs N. of S.W. cor. of 3 N 87° 30' W 4.05 chs S 7° 22' W 12.10 chs to S. line N.E. 1/4 E 5.64 chs to beg. Except 3-343 above