(10)

5170. set hub on brow of hill slopes N.E.
5280 " " no trace of old Cor. of Secs 11-12-13-14.
I afterwds set Sec. Cor. 68.9 Ft. E and on line with cor. 1 mile
Thence I continue N 0°-58' W. on Random
set Secs 11-12.

1000. set hub on top hill E & W.
1320 Road E & W. Riverdale to Hooper.

2640 set hub. no trace of 1/4
5275 set hub.

5290.5 set hub find old Cor. Secs 1-2-11-12. 137.8 ft E,
a red sand 18 x 4 x 4 - makes entire dist
from Cor Secs 13-14-23-24 to the cor. of Secs
1-2-11-12, 10582.3 ft as measured to

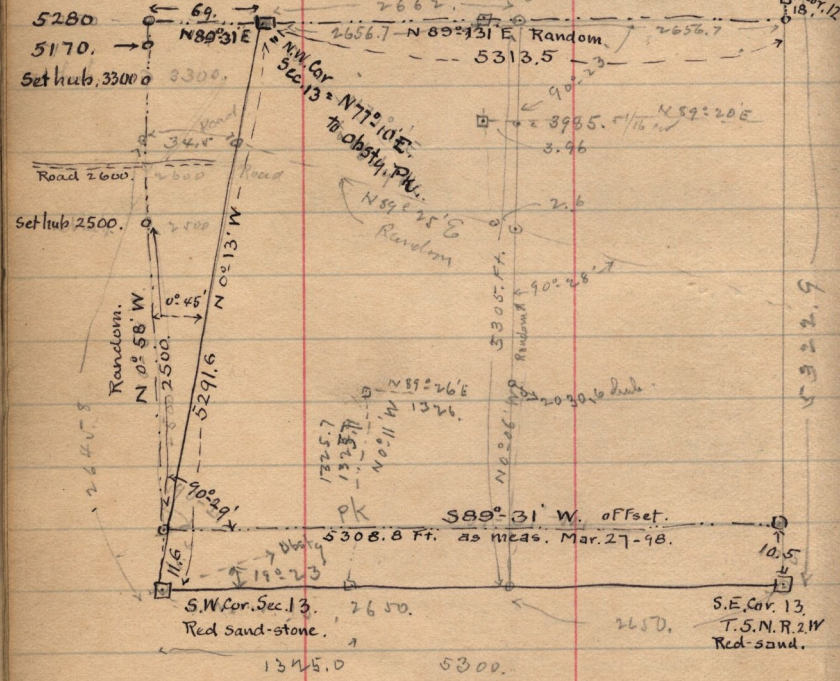


5291.6
2645.8
1322.9

5314
5291.6
10605.6
5302.8
1325.7