

WASHINGTON JENKINS CIV. ENGR.

G-499-100.

Lee Bybee & wife to Geo. M. Ritter.

May 17 - 1871 - Pt S.E. 1/4 Sec. 13, T. 5, N. R.

2-W. Brq. 20. ch. S 42.0. ch. W. of N.E. cor.

2d 1/4 - E 18.44 ch. - N 25° 38' W. 7.71 ch.

W 15.10 ch. S 6.95 ch to brq.

also Brq. 2.08 ch. S 4. 20. ch. W. of N.E. cor.

2d 1/4 - S 77° 28' E. 11. ch. N 25° 38' W. 1.18

ch. N 9° 42' E. 21.57 ch. N 0° 38' E. 3.81 ch.

N 86° 56' W. 13.83 ch. S 24.82 ch. to brq. 44.2 ch

to survey above 1st des. I brq at N.W. cor. N 61° 49' S. E. 1/4 Sec. 13.

Rim S 0° 05' E - 96. W fence S 77° 28' E. on latter line descend hill

187.2 feet high, 337.2 bottom of hill N 24.5 W. then a fall


637. brq. to ascend steep hill S 84° N.W. 182.2 set stakes

on top of hill. 861.2 set stakes at G. Ritter N.W. cor.

1320. set stakes for Geo. Ritter

N 89° 19' E = N. line Sec. 13

= N.E. cor. Sec. 13

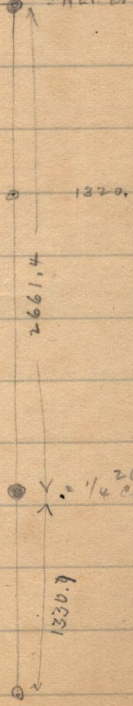

note this

NOTE. From N.E. cor. of Geo. M. Ritter, original tract in S 1/4 Sec. 13. a strip of 37.5 ft. lies S. + East. this line and the track decided by man to Miller.