
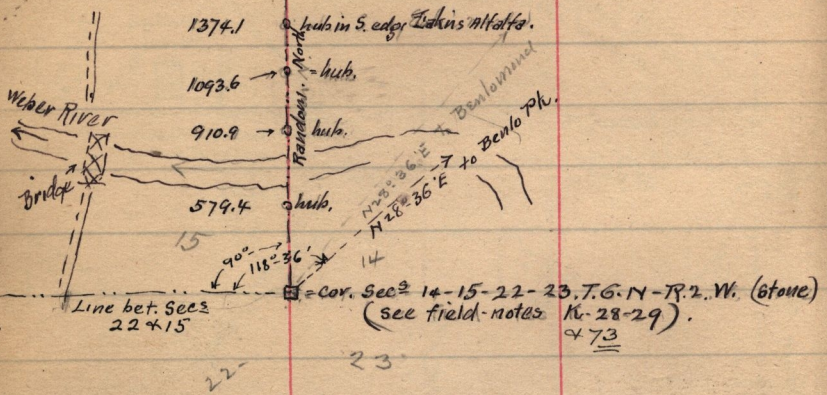


old fence on N. line of John Eskins farm.

April 27-1898.  
M<sup>c</sup>Farland

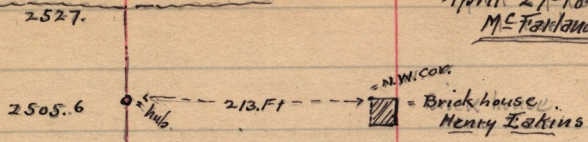

Jas. Mack.

May 4-1898.

copy deed from D. H. Peery to James Mack - June 20-1896.

Pt Lot 3, B. 66. Plat C, Ogden City, Surry. - and und 1/4 of  
beg. 6.8475 chs. S. of N.W. cor. sd lot. - S 1.4975 ch.  
E 2.90 chs. N 32° 12' W. 1.13 ch. N 5° 24' W  
554  
1000 of 1 ch. to pt E. of beg. W 2.26 ch. to beg.

