


See description on page 5

May 9-1898
A.G. Horn

old cedar
hut.

centre Jackson Ave
N 0° 58' E

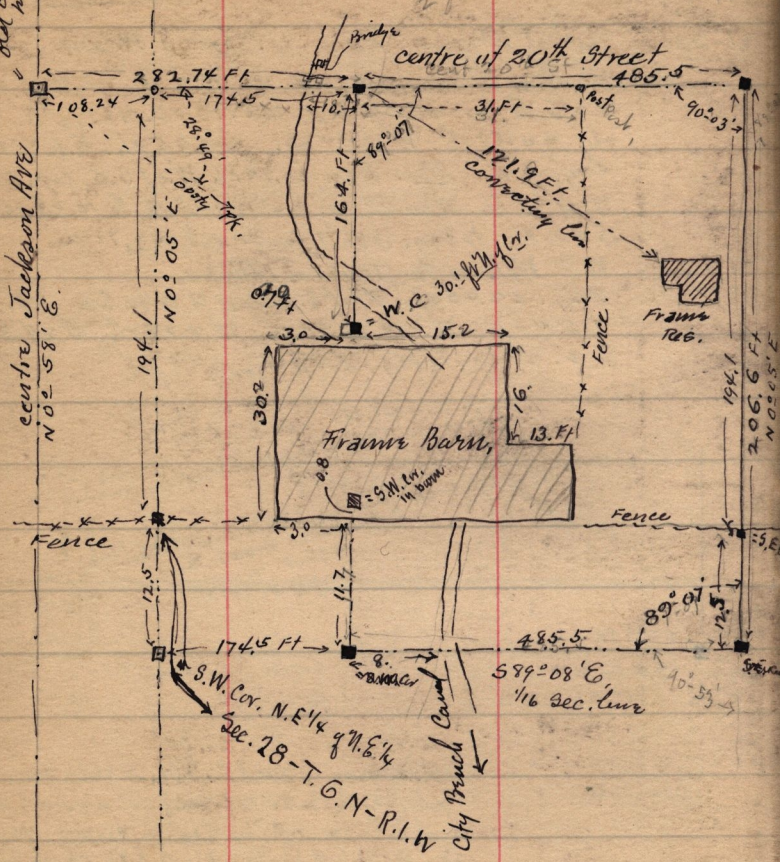

5

centre of 20th Street

Bridge

Post

Framm 186.

Framm Barn

S.W. 1/4

Fence

Fence

City Branch Canal

S.W. Cor. N.E. 1/4 of N.E. 1/4
Sec. 28-T. 6. N-R. 1. W

599° 08' E
1/16 Sec. Line

90° 53'