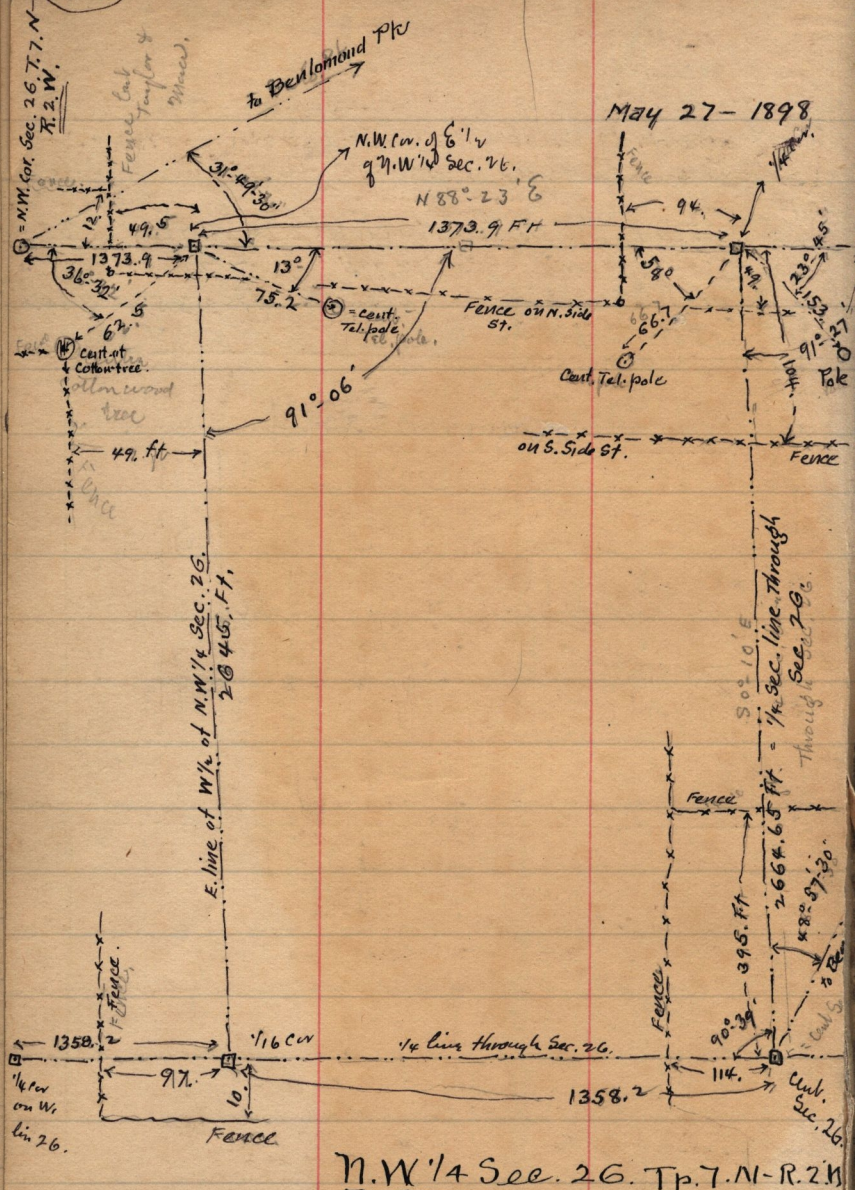

N.W. 1/4 Sec. 26. Tp. 7. N. - R. 2. W.

Notes continued on page 27

(See Plat Book - p. 56)