WASHINGTON JENKINS CIV. ENG. (JN.)

October 24th 1898.
Survey made for
John Nicholas
in Kings Addition

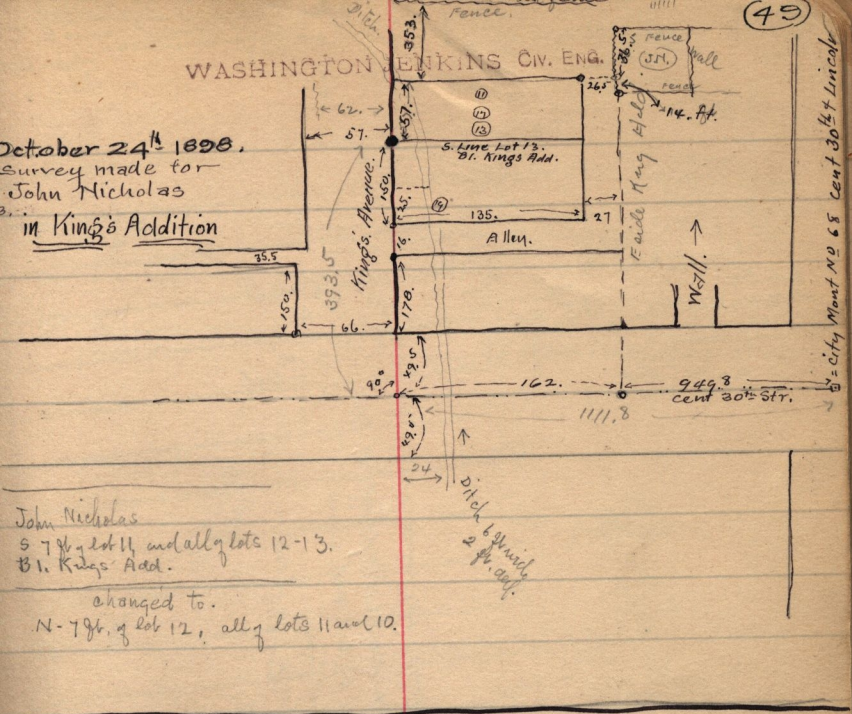

John Nicholas
S 7½ ft of lot 11, and alley lots 12-13.
Bl. Kings Add.

changed to.
N-7½ ft of lot 12, alley lots 11 and 10.

Oct. 26-1898.

Made survey of the F.T. Sanford tract, for M. E. Malone.
in S.E¼ Sec. 19.- and N.E¼ Sec. 30. T. 7. N— R. 1. W

See page 26
" " 47

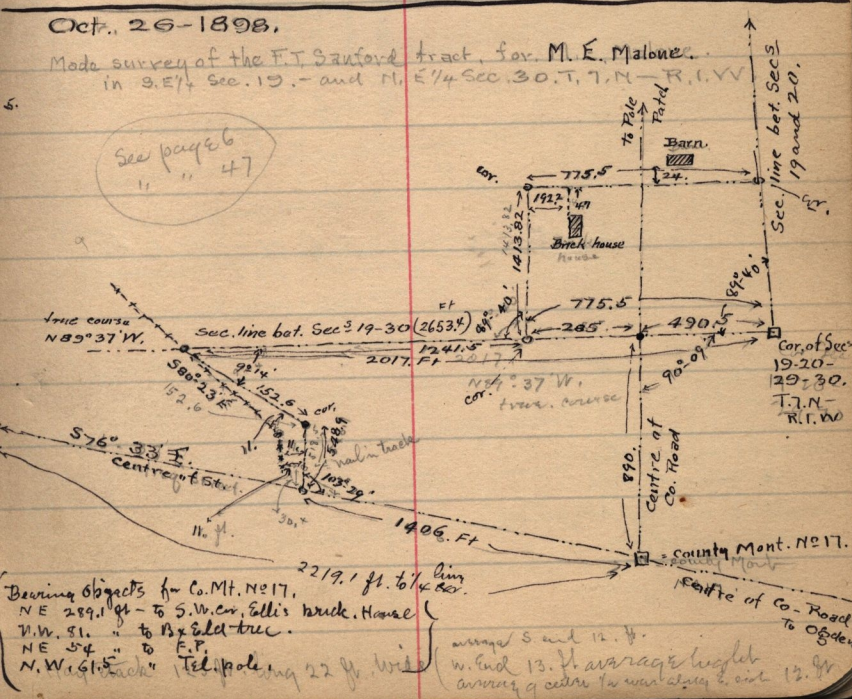

Bearing Objects for Co. Mt. No 17.
NE 289.1 ft - to S.W. cor. Ellis brick. House
N.W. 81. " to B & Elder tree.
NE 54 " to E.P.
N.W. 61.5 " Tel. pole.

average S and 12. ft.
W. End 13. ft. average height
average of center for west stone S. side 12. ft.