(50)

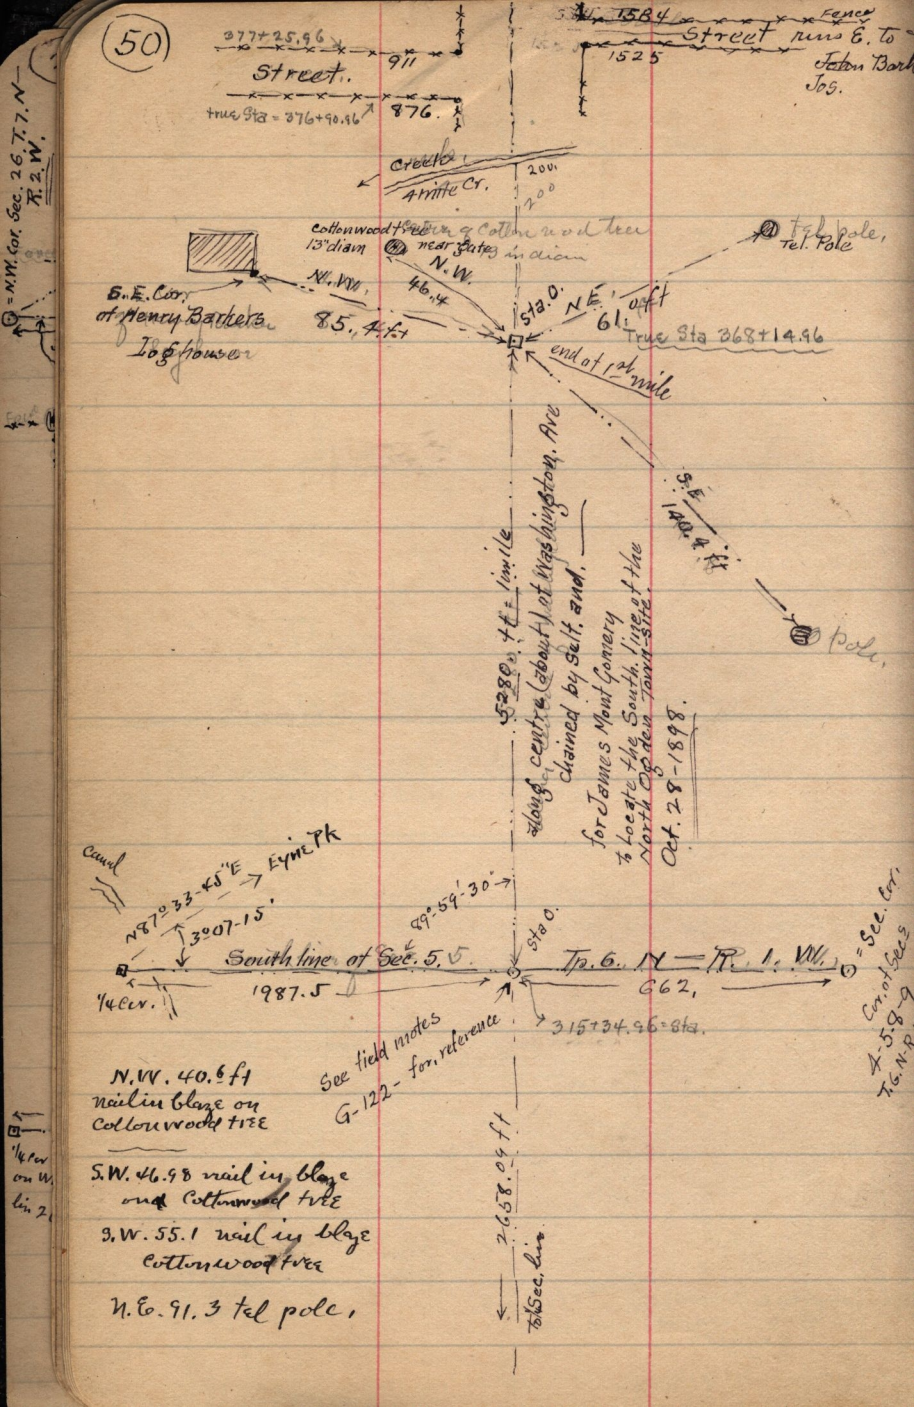
377+25.96
911
Street.
true Sta = 376+90.96
876.
1584
Fence
Street runs E. to Joseph Bark Jos.
1525
Creek
4 mile Cr.
200.
700
Cottonwood tree 13" diam
Cottonwood tree near gate
Cottonwood tree 14" diam
Tel. Pole
Tel. Pole,
N.W.
46.4
N.W.
85.4 ft
S.E. Cor. of Henry Barbers Log house
Sta 0.
N.E.
61. ft
True Sta 368+14.96
end of 1st mile
5280 ft = 1 mile
along centre (about) of Washington Ave
Chained by self and
for James Montgomery
to locate the South line of the North Ogden Town Site.
Oct. 28-1898.
S.E.
140.4 ft
Pole,
Canal
N 87°33'45" E
Eyre Pk
3°07'15"
49°59'30"
Sta 0.
South line of Sec. 5.
Tp. 6. N — R. 1. W.
1/4 Cor.
1987.5
662,
315+34.96 = Sta.
= Sec. Cor.
Cor. of Secs. 4-5-8-9 T.6.N.R.
See field notes
G-122 - for reference
N.W. 40.6 ft
nail in blaze on Cottonwood tree
S.W. 46.98 nail in blaze on Cottonwood tree
S.W. 55.1 nail in blaze Cottonwood tree
N.E. 91.3 tel pole,
2638.04 ft
to Sec. line
= N.W. Cor. Sec. 26. T.7.N. R.2.W.
1/4 Cor on W. line 2