


WASHINGTON JENKINS CIV. ENG.

New

Feb. 14 - 99, Continuation of Survey of Co. Road near Fahy's & Stangers in Sec. 14, T. 6. N. 2. W.

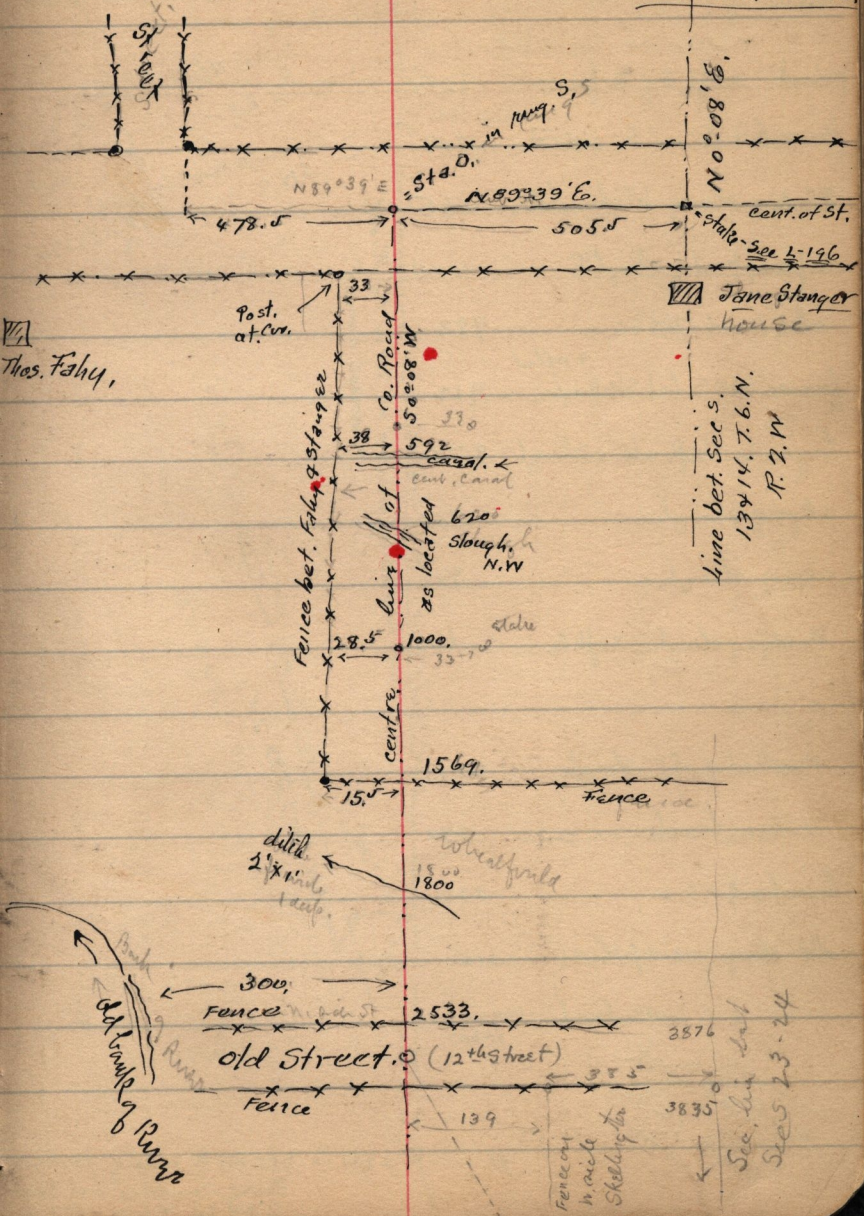

N 89° 39' E

N 89° 39' E

N 0° 08' E


line bet. Sec. 5, 13 & 14, T. 6. N. R. 2. W.

1569

2533

3876

3835

300

old Street (12th street)

139

Post. at Cor.

Jane Stanger house

Thos. Fahy

Slough N.W.

1800




See line bet Secs 23-24

Fence on N. side of Skelington

Bank of Run

wheat field

1000


















