


Sunday Feb. 19-94.

Angle 24° 18' 30"
Centre of Mass from N 0° 00' E true

- computed at 1240.7
- point 30 ft. S of N. fence 1230
- computed 1216.
- fence E + W. on S. side St. 1208.
- N. edge of slough 6' above bottom 1065
- deepest part of slough 'b' 1020
- old road N45S. 983
- fence N45S. bet. Skellingham & wellhead 912
- begin to drop into slough 870
- edge of slough 800
- edge of slough 700
- N. edge of slough 20 ft E. 600

Line ran along centre of new Co. Road through brush.

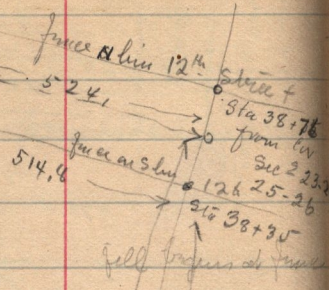

N 24° 18' 30" W true angle

Line bet. Secs 23 & 24
N 0° 49' 30" E
1104 ft

25° 00'

- West end of old slough 300
- entrance brush 290
- leave brush 226
- old slough no depth 215.
- entrance brush 1120

cos 25° = .9063
tang 25° = .4663

See Field Book page 143 or

2731. = Sta. on N. side of Wolber River. on line bet. Sec 23 & 24. T.G.N - P. 2 W

N.M. Cor. Sec. 26, T. 7, N.

1/4 in on W. line 2