
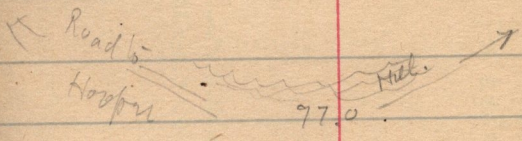


WASHINGTON JENKINS CIV. ENG.  
26+53.5

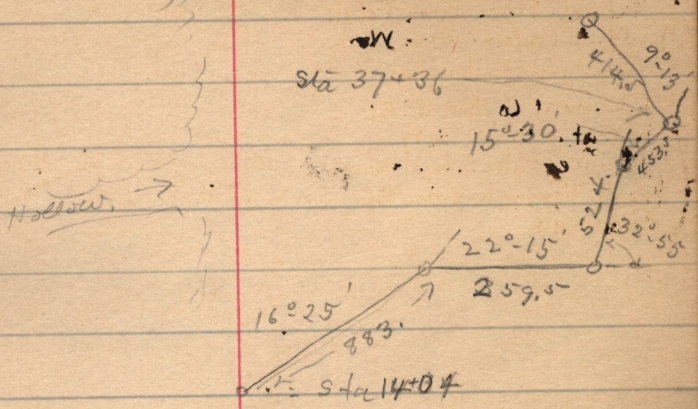

see book J. page 138.

Ca. Mont N<sup>o</sup> 56. is 351.78 ft. S. of  
 27.72 ft. N 87°10'30" W. of the 1/4 cor  
 lot Sec 7+12. W. bdy Tr.  
 5N-R. 1.W.