80

See Book D. P. 106

March 11-1899 — Weber Co. 1/2 acres.

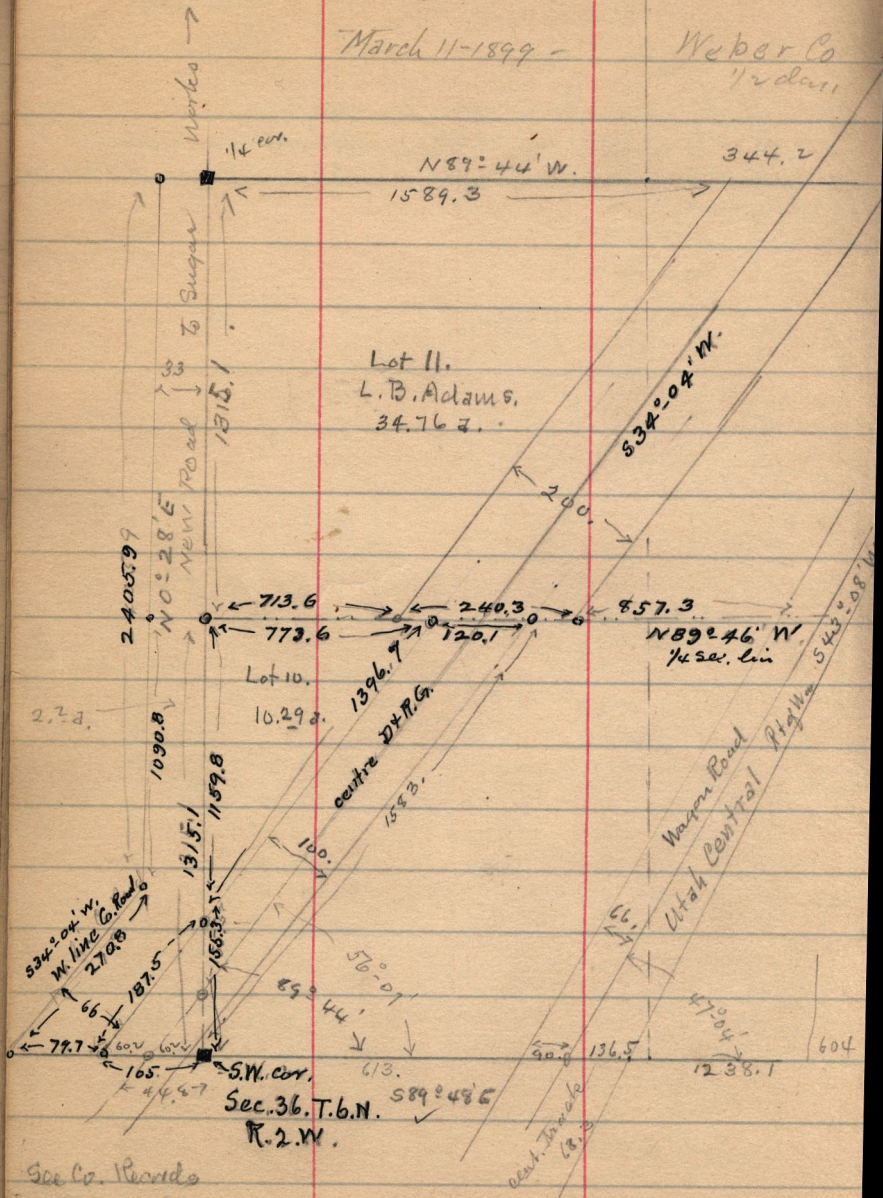

See Co. Records plat Book. 6. page 69. + 65

see plat book page 49