


Mar. 27-1897
 Survey made for Baker Tr. Lot. 3, B13, Plot A.
 Ogden City Bury Prq. at SE. cor. rd. lot.
 Thence N. 30° W 8 R. 53 R. E. 8 R. 4 C. 9.
 Survey made from City Monte.

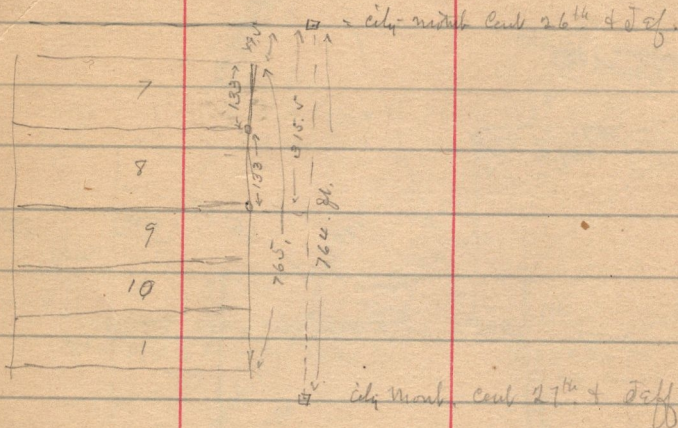

the NE. cor. of the above tract is 9.7 ft. W. + 2.5 ft. S. of fence rd. W.

The SE. cor. is 9.7 ft. E. of st. fence + 1. ft. S. of br. wall. pr. W.

The SW. cor. is at S. edge of brick wall.

Traverse Table of the N. End of the Allen tract in S.W. 1/4 Sec. 5. T. 5. N. R. 1. W.

| | N- | S- | E- | W- |
|------------|-------|-------|-------|-------|
| N13° 28' E | 195.1 | | 45.4 | |
| S80° 26' E | 61.4 | 10.2 | 62.5 | |
| N0° 27' E | 231.0 | 231 | 1.8 | |
| S82-30° E | 357.1 | 46.6 | 354.0 | |
| S3° 10' W | 365.9 | 365.3 | | 20.2 |
| N89° 49' W | 441.6 | 441.5 | | 441.5 |
| | 422.1 | 422.1 | 461.7 | 461.7 |

N.W. cor. Sec. 26 T. 7. N. R. 1. W.

1/4 cor. on W. line 26