WASHINGTON JENKINS CIV. ENG.

June 7-1899

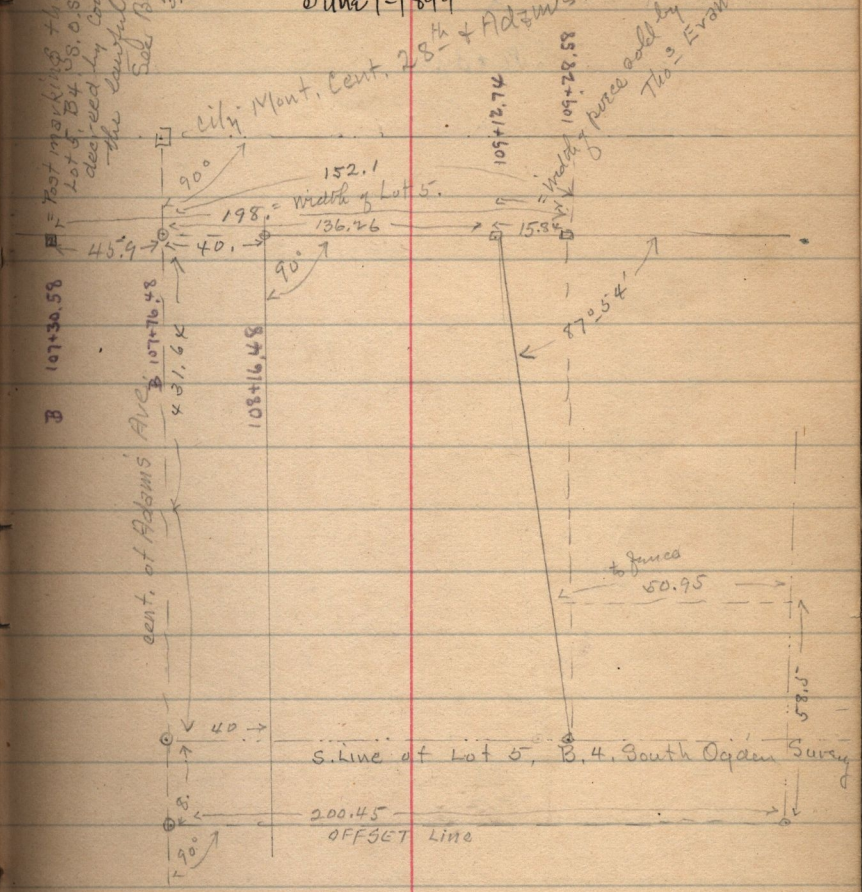

June 8-1899

See page 19 – this book.

Copy of deed from Jennette McKay to Peter Lowe.

Beg. at S.E. Cor. Lot 5. B. 4. S.O.S. E. 50. ft. N 50.88 ft. W. 51.86 ft. S 2°-06' E. 50.88 ft. to beg.

Copy of deed from Jennette McKay to Ann C. Gibbons

Beg. 50. ft. E. of S.E. Cor. Lot 5. B. 4. S. O. S. – E. 473.9' ft. to the line. bet. Lots 3 and 4 in said Block. N 44°43' W. 72.9 ft. W. 421.8 ft. to pt. N. of beg. S 50.88 ft. to beg. .52 a.

(3½)

deeds written by self. (See page 19)