


Sept. 12-1899.  
West Cache Ir. Canal.

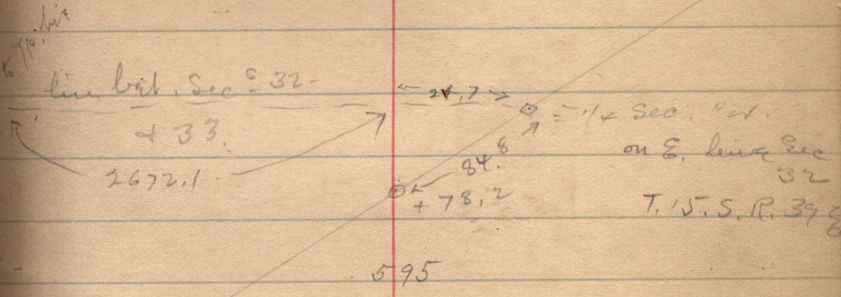

Hog Back.

