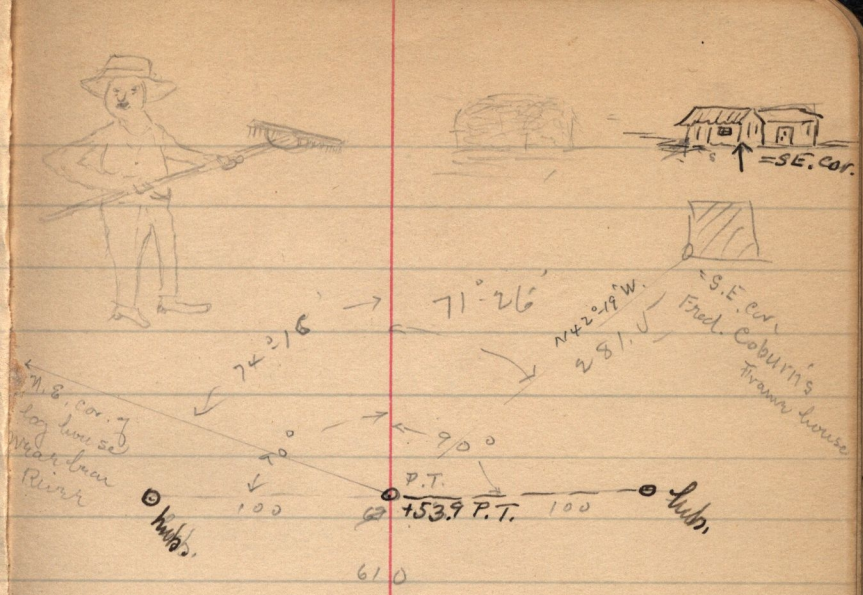
=SE. Cor.
S.E. Cor.
Fred. Coburn's
Frame house
71°-26'
N42°-19' W.
281.5
74°-16
N.E. Cor. of
log house
near bear
River
90°
90°
P.T.
+53.9 P.T.
100
100
hub.
hub.
610