WASHINGTON JENKINS CIV. ENG. West. →

approx. N. line sec. 8 ← +96 3285 →

to Cascades 7-8-17-18

south

8022 ft

645

the new line intersects old at sta. 645+72.6 by old numbers

old line

new P.T. 645+67.4

57.8

= new P.I. 645+11.

70.6

644+46.5 P.I. →

57.8

= new P.C.

old line

old line

intersect old line 645+ +67.4 P.T.

angle Right 22°50'

T.D. 20°C = 57.8

+11. P.I. 645

644 +53.2 P.C.

new curve

644+53.2 = 0°00'

645+75 = 2°11'

645 ~~+50~~ = 9-41

645+50.4 = 9-41

+67.4 = 11-25

640 + 482.2 P.T.

new angle Right 44°20'

TD 36°C = 64.8

P.I. 640+23.9

640

to Dec.

639+59.1 P.C. new

New Line ran from

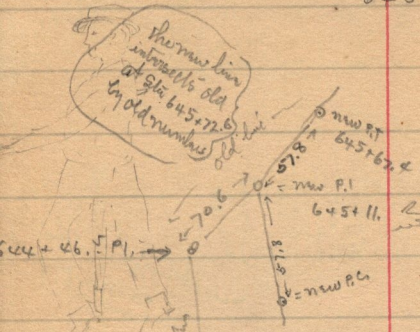

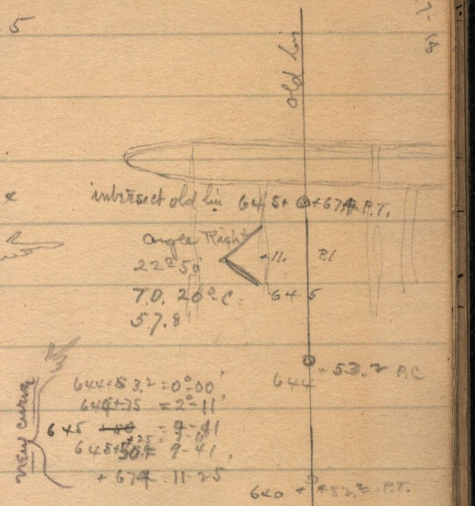

58.10

34800

34860

373.400

2640

1094

15

+ 60 old wreck of loghouse

Leonard Litz.