

WASHINGTON JENKINS CIV. ENG.

88.6

↑ +220  
687

angle

212° 01'

T.D. 8° 00'

1393.5'



Chatterton's  
house.


900



new P.C. 683+90.0 P.C. 683+60.0  
 $\phi = 7.2583+60.7$

afternoon Sept 14-99

Parker went to Ogden  
 Butler took him to  
 Cannon Sta.

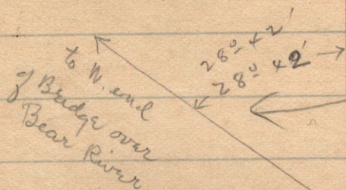

Strip sandy slopes  
 + 51.0

Feb 18-1902  
 3rd & Final Location

845-45 W  
 P. 70 = 686 + 34.4 = 10° 50'  
 686 = 9° 29'  
 .60 = 7° 29'  
 685 = 5° 29'  
 +50 = 3° 29'  
 684 = 1° 29'  
 P.C. 683+63.0  
 524 ± 0.5

Angle  
 Right 212° 40'  
 T.D. 8° 00' = 137.0


The only dist.  
 bet. 2nd & 3rd Location  
 was 8' e. in place P.C.  
 of a 10° c. at P.I. 685



680

hub.

new P.T. = Sta 679+58.0  
 +49  
 679  
 old P.T. = Sta 679+49.0  
 +49 = 25° 25'  
 20° 30'  
 75° 18' 00"

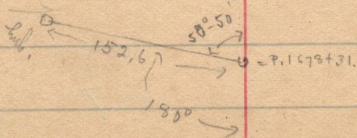

T.D. 20° 00' = 136.1

new curve

50 2 15 30  
 P.I. 678+11  
 678 = 10° 30'  
 75 8-00"  
 +40 = 5° 30'  
 +25 = 3-00"  
 0° 30"

676947 P.T.C