




F. G. Lulce
of Salt Lake
City.

Began here Saturday
morning Sept. 16-1899
Butler went to Weston and
back. ☺

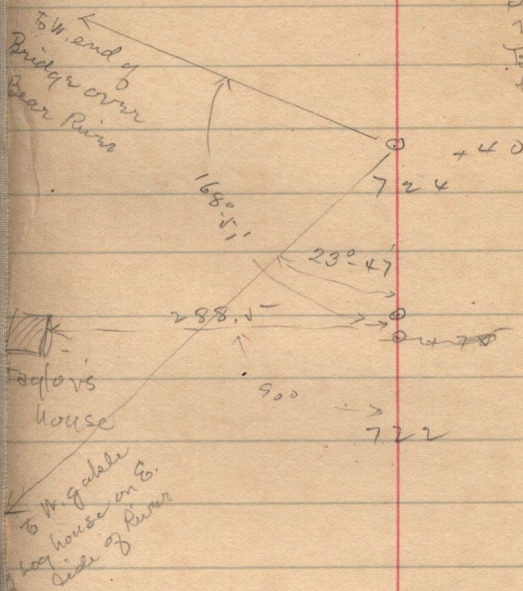

To W. end of
Bridge over
Bear River

Taylor's
house

To W. Galah
log house on E.
side of River

Level

0 + 05.5 - holo.

