


Jas. Dawson. Log house



N.W. cor log house

Jas. Dawson

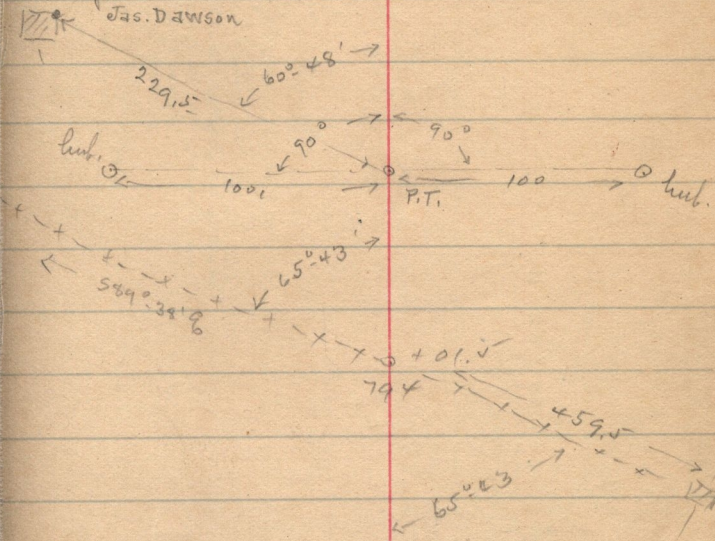

large  
 stone to mark  
 the W. sec 5  
 17-18-19-20  
 Tp 16-S.  
 R 39 E

Why dont you bring the  
 Canal higher up