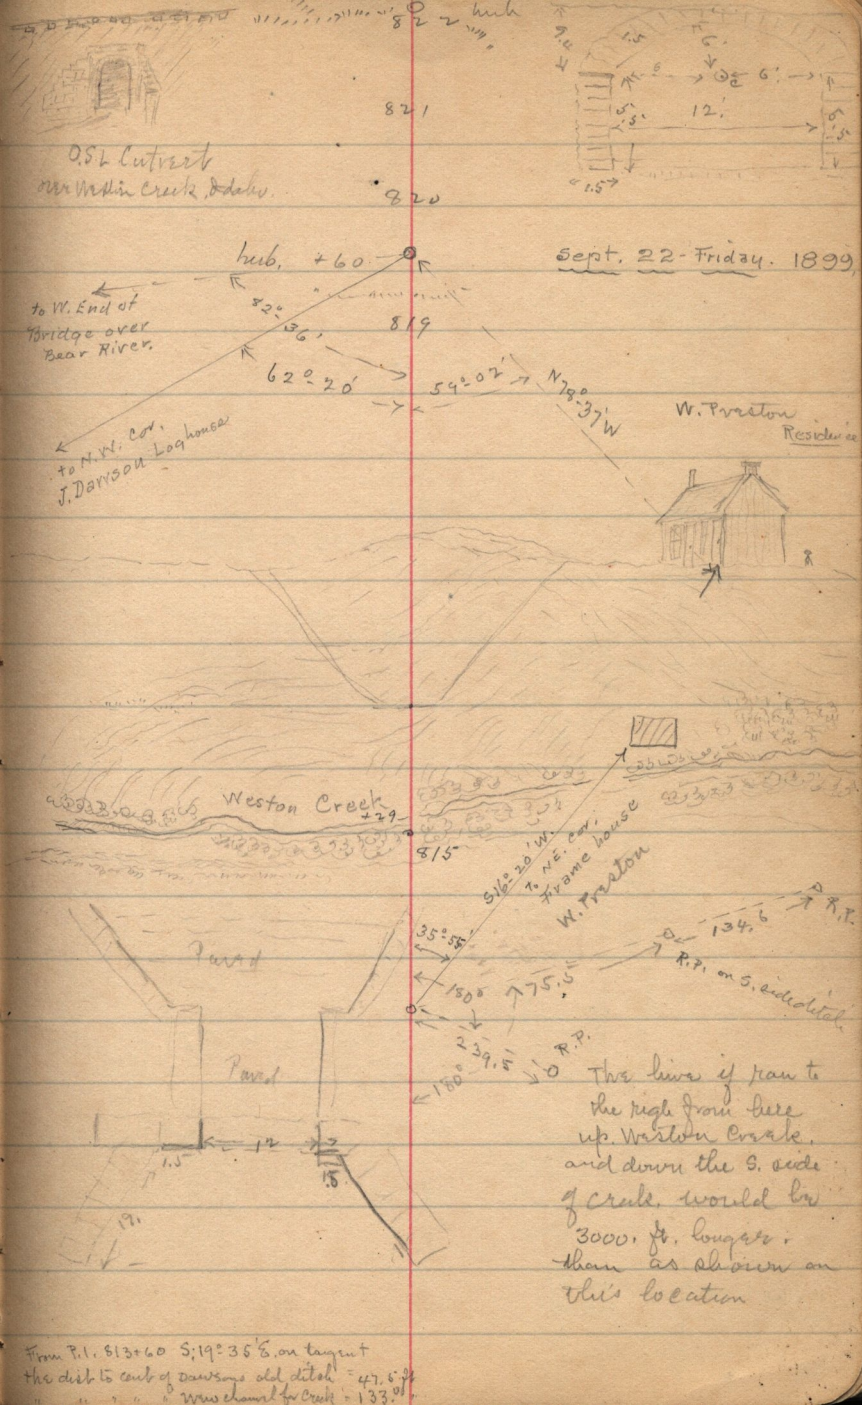

The line if ran to the right from here up Weston Creek, and down the S. side of creek, would be 3000. ft. longer, than as shown on this location

From P.I. 813+60 S; 19°-35' E. on tangent
the dist to cent of Dawsons old ditch = 47.5 ft
" " " " " New channel for Creek = 133.0 ft