


For cross-section note of new location see Lars / Book 4, page 25.

Lars Rasmussen

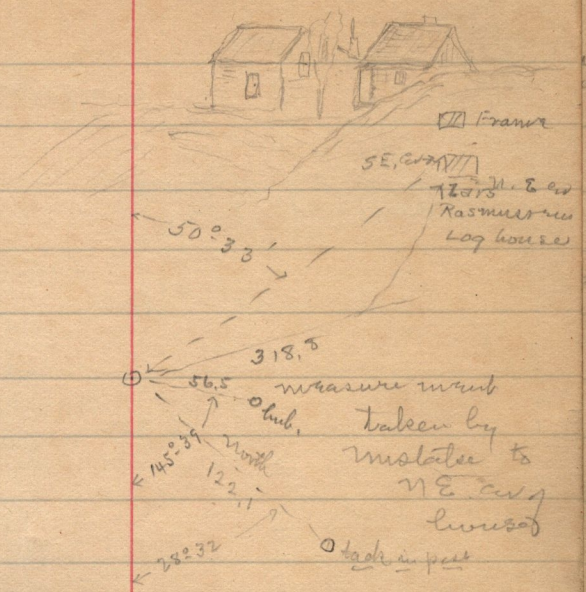

Bert Homer (roofer)

