
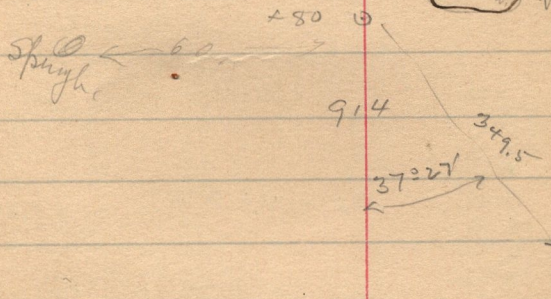


$17 + 29.6 = 27-58$   
 $+ 25 = 27-03$   
 $917 = 22-03$   
 $+ 75 = 17-03$   
 $+ 50 = 12-03$   
 $916 + 25 = 7-03$   
 $916 = 2-03$

deflections  
New curve

$915 + 48.7 = 44-18$   
 $915 + 25 = 32-27$   
 $915 = 19-57$   
 $914 + 75 = 72-27$

deflections  
aligns  
New curve

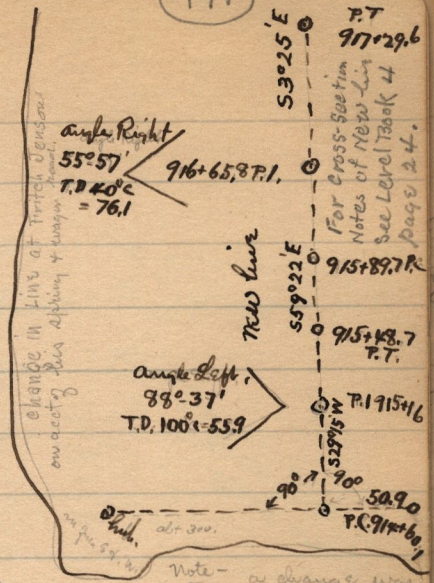

Springs

Party from  
 Fritch Johnson

