


to chimney on
White Pond
school

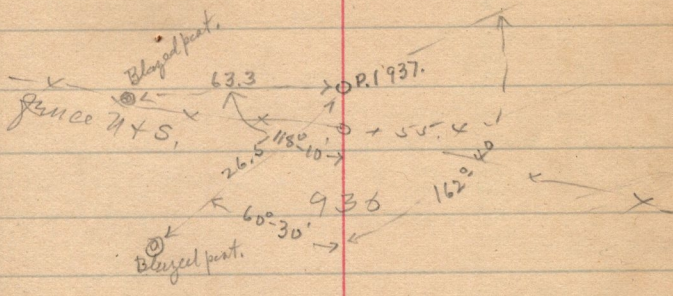

935-

O + 50. hubs.

934

M.F. JENSON - dead

S.E. 1/4 of Sec. 30, Tp. 16S
R. 39E, of Boise Mer,
160. a.

O + 68.5 hubs.

930