


O.S.L.
53°-53'E



Note, a change was made in the location, beg. at Sta 982 + 40 (see Field Book 3 - page 44)

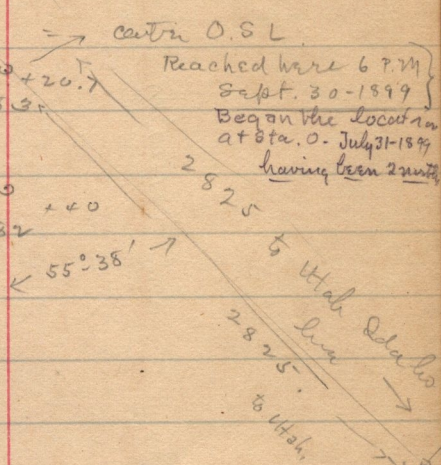