


37-546

Sarah Corvax Herrick - L.A. Herrick & Lydia E. Herrick
to Annie L. Rich

Pl. Lots 3-4-5-Blk 12 - Plat A, O.C.S.

Beq. 110. ft. S. of N.W. Cor. lot 5 - E. 24 Rods - N 110. ft. W 16 R.

(Aug. 26-1904 Survey for J. L. Herrick)

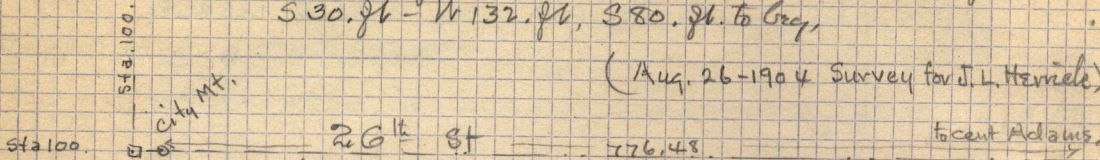

Washington Ave.

OFFSET LINE 10' W. of center 76.265' City Record,

(64 ft. 6 in)

302.326

Cor. Point o. W. ft. n. of Cor. Post
N.W. Cor. Lot 5

110.

center of 30 ft. alley

Block 12-A

Sta 92+36.35
City Mt. 69.6' nail

27th Str.

776.48