Sept 12-1904

Survey for John Woodfield, North Ogden

{E.L. Short Asst. #3.
Thos. Jenkins #1.

Description - Pt. N.W. 1/4 Sec. 4. T. 6. N-R. 1. W.

Beg. 491.2 ft. W. of N.E. cor. ad 1/4 sec. W 679.1 ft. - S0°-47' W 1134.8 ft. to cent St. S 88°-58' E. 715.1 ft. - along cent St. N0°-38' E. 912.1 ft. to channel of mud creek. W 33. ft. along said creek. N0°-38' E 235.3 to beg. also beg. Pt. S.W. 1/4 Sec. 33. T. 7. N-R. 1. W. Beg. 491.7 ft. W. of S.E. cor. ad 1/4 sec. W 679.1 ft. N 0°-47' E. 207.6 ft. S 89°-34' E 678.5 ft. S0°-38' W. 202.5 ft. to beg.

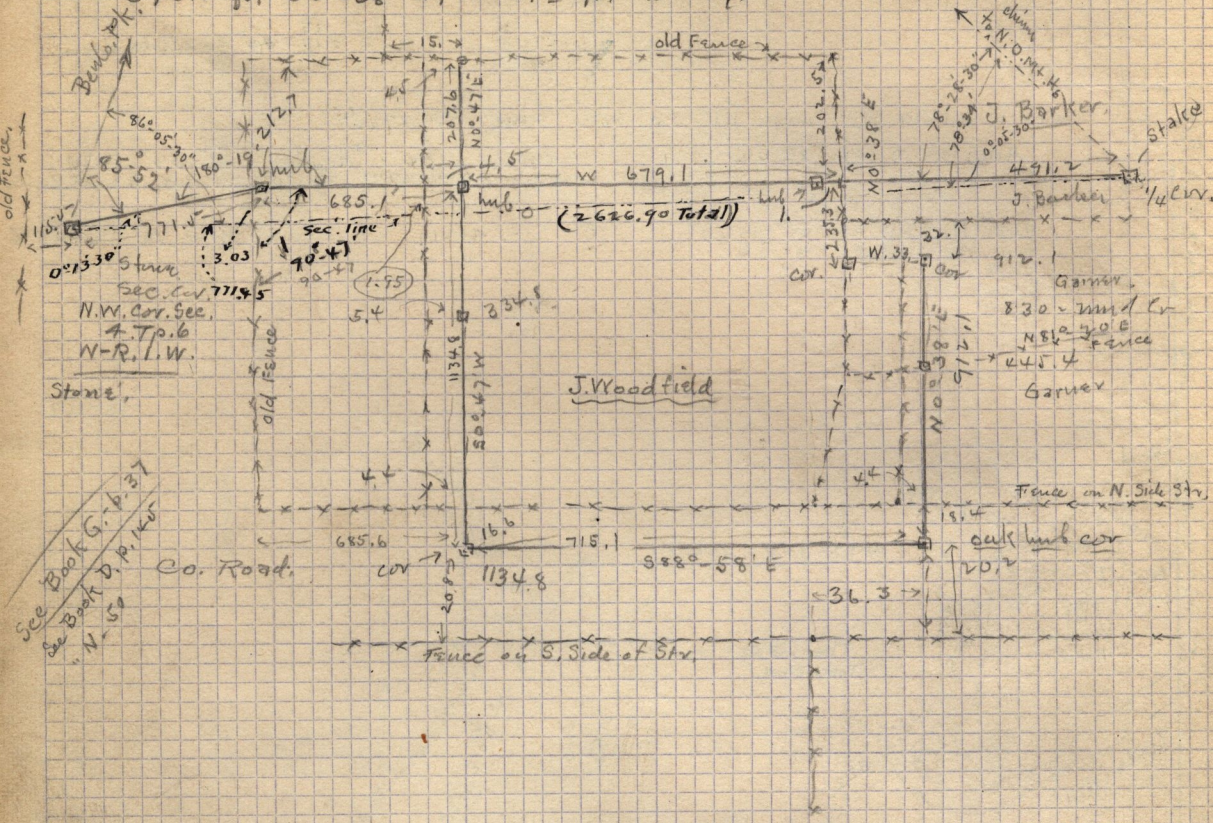

771.5
685.1
1456.6