(15)

# Stanley Survey -
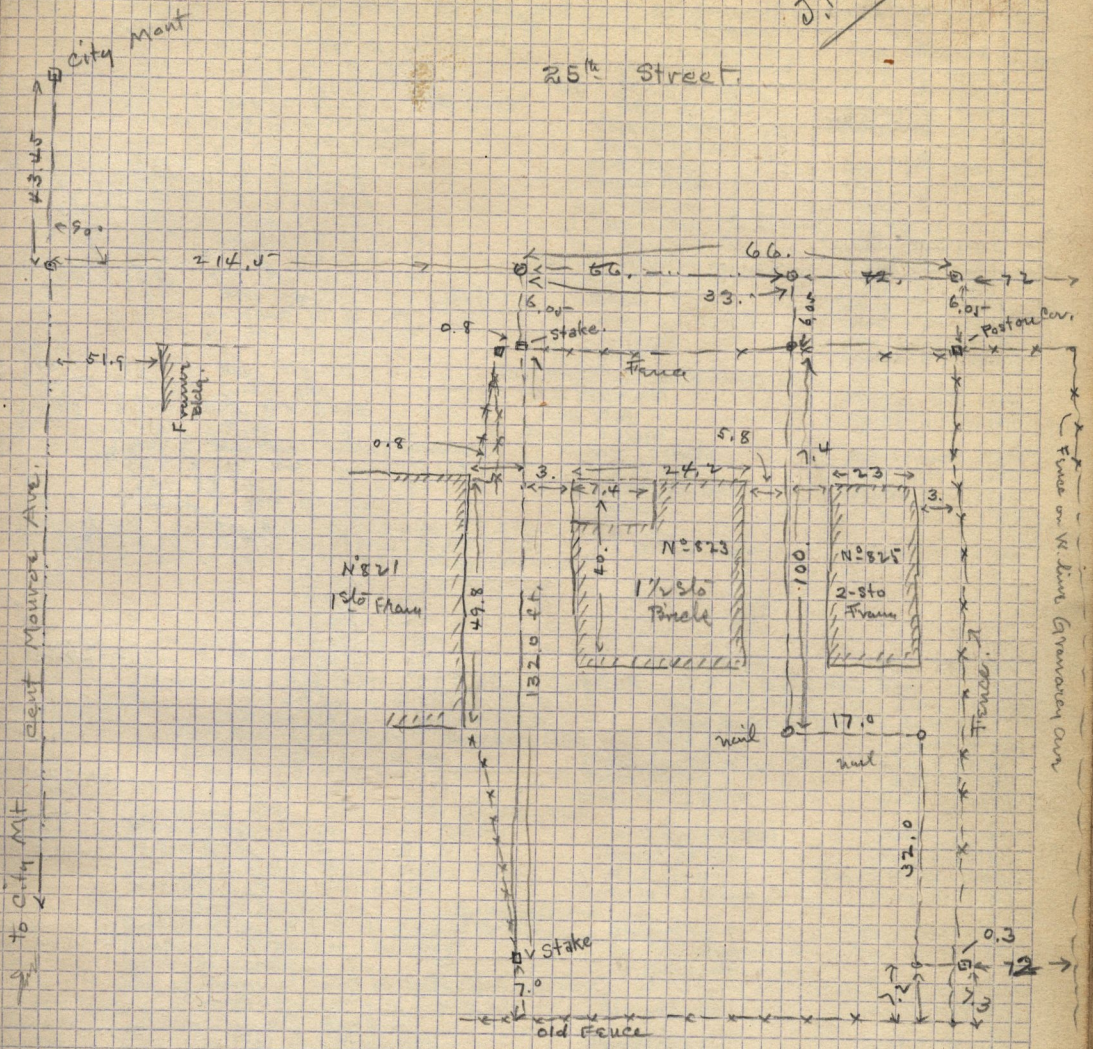
Self.
E.L. Shook
J.F. Culley
1/2 day