


Survey for Samuel Blair - Oct 3-1904 -  
Description - from Abstract N 1/2 of Lot 9 - Block 29 - Plat A. O.C.S.

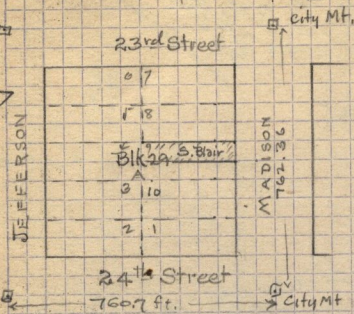

E.L. Short  
J.F. Cully

7+62.9  
7+10.8

Bad Fence  
5+87.3

Emmerson

S. Edge Cox post.  
4+48.4

S. Blair

N. Edge post.  
3+81.5

S. edge post.  
3+47.85

N. Edge Cox post.  
3+27.4

3+18.215  
stone

Drive  
2+75.7  
2+65.4

Drive  
2+31.1  
2+20.5

S. Edge Cox post  
1+41.7

I.L. Clark  
1+31

0+49.5

23rd Str.

City Mount

7

8

Block 29 -  
Plat A

N.E. cor  
Lot 9

9

10

1

By today's measure  
I need 5 inches.

Center of Madison Ave

Fence on W. side of Madison Ave

center of Madison

City Mount

24th Str.