(17)
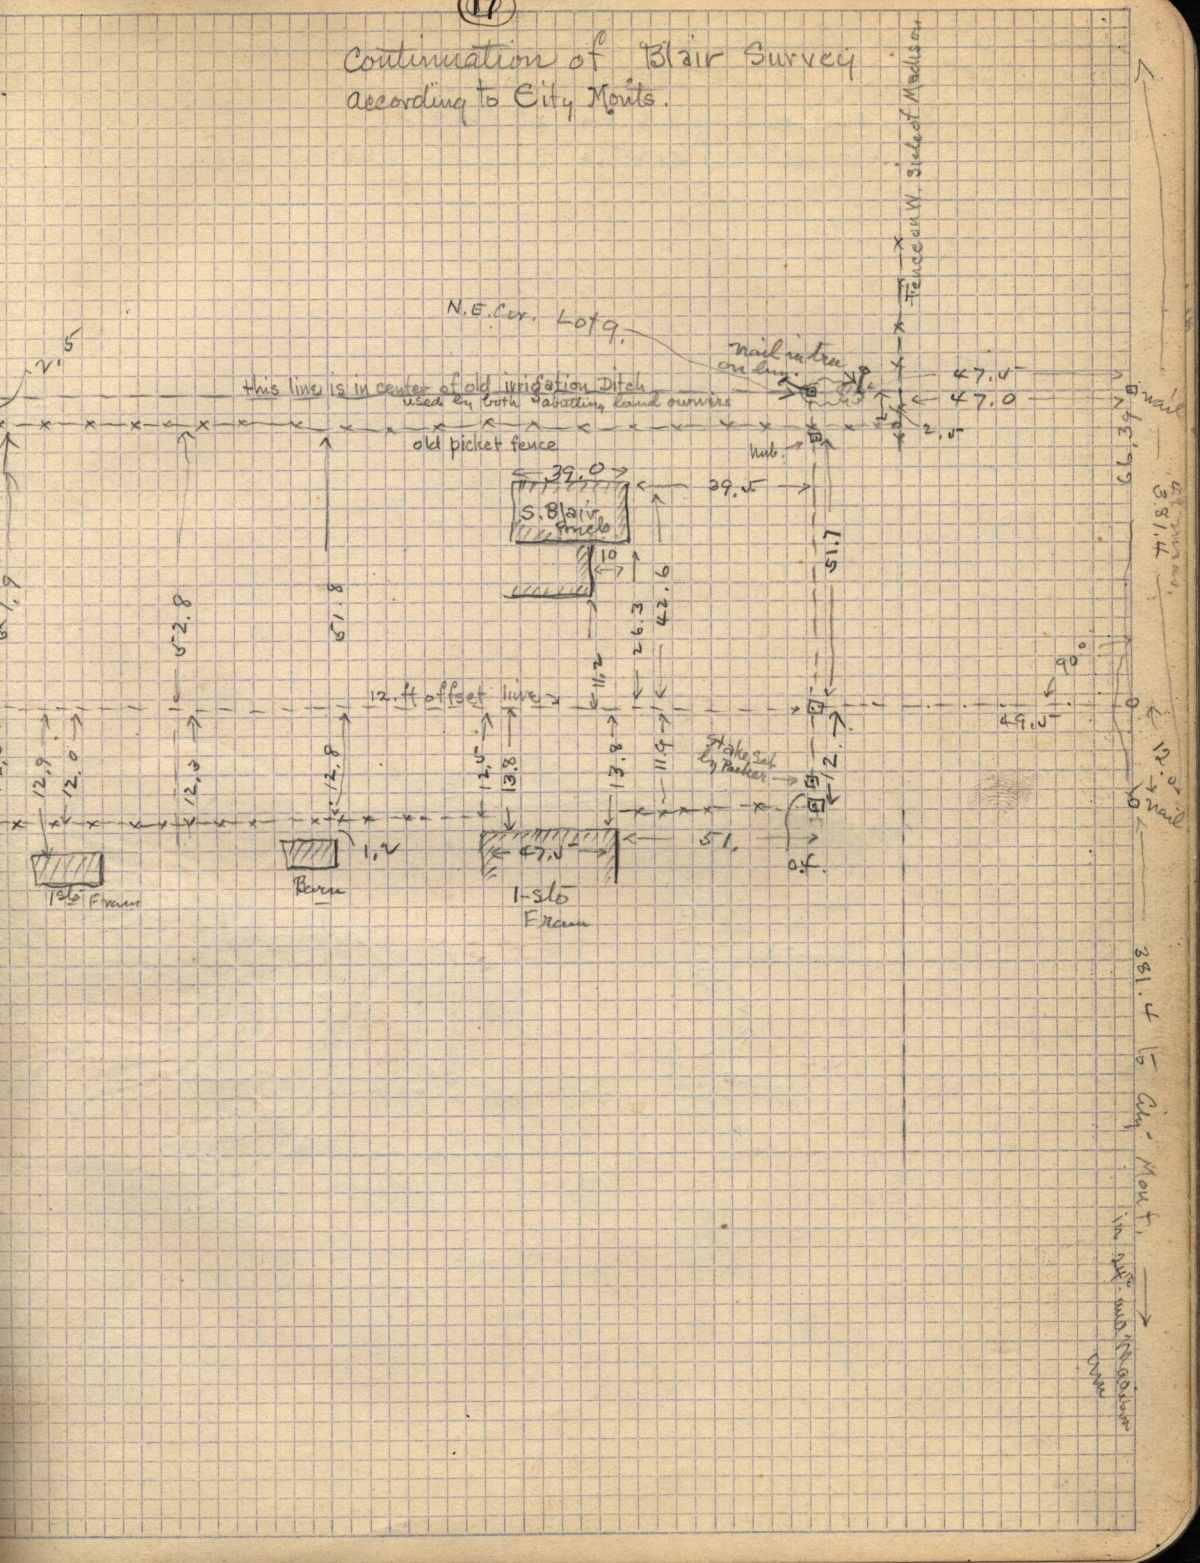
Continuation of Blair Survey
according to City Monts.