Traverse Table of Stimpson Tract as Surveyed on opposite page 21 -

		N	S	E	W	
N 38° 21' E	798.2	625.9		495.2		
S 52° 49' E	383.0		231.4	305.1		
N 38° 21' E	112.0	87.8		69.5		
S 55° 39' E	512.0		288.9	427.7		
S 36° W	658.3		532.6		386.9	
West	449.9				449.9	
N 53° 20' W	568.1	339.2			455.7	
		1052.9	1052.9	1297.5	1297.5	about 16.4 acres.

Description of above survey - Land to be conveyed by Wm Stimpson to Wm Stimpson Jr.
Pt of N.W 1/4 Sec. 8 - Tp. 5. N — R.1.W. S.L.M. U.S Surv. Beg. at a point 178.0 ft. North and 788.9 ft. N. 67° 50' E. from the S.W. cor. of said 1/4 Sec. Running thence N 53°-20' W 568.1 ft. to the center of County Road. Thence N 38° 21' E 798.2 ft. along the center of County Road. thence S 52° 49' E 383.0 ft. thence N 38° 21' E 112.0 ft. Thence S 55° 39' E 512.0 ft. thence S 36° 00' W. 658.3 ft. to a point East from the place of beginning thence West 451.0 ft. to beg. abt 16.4 acres.
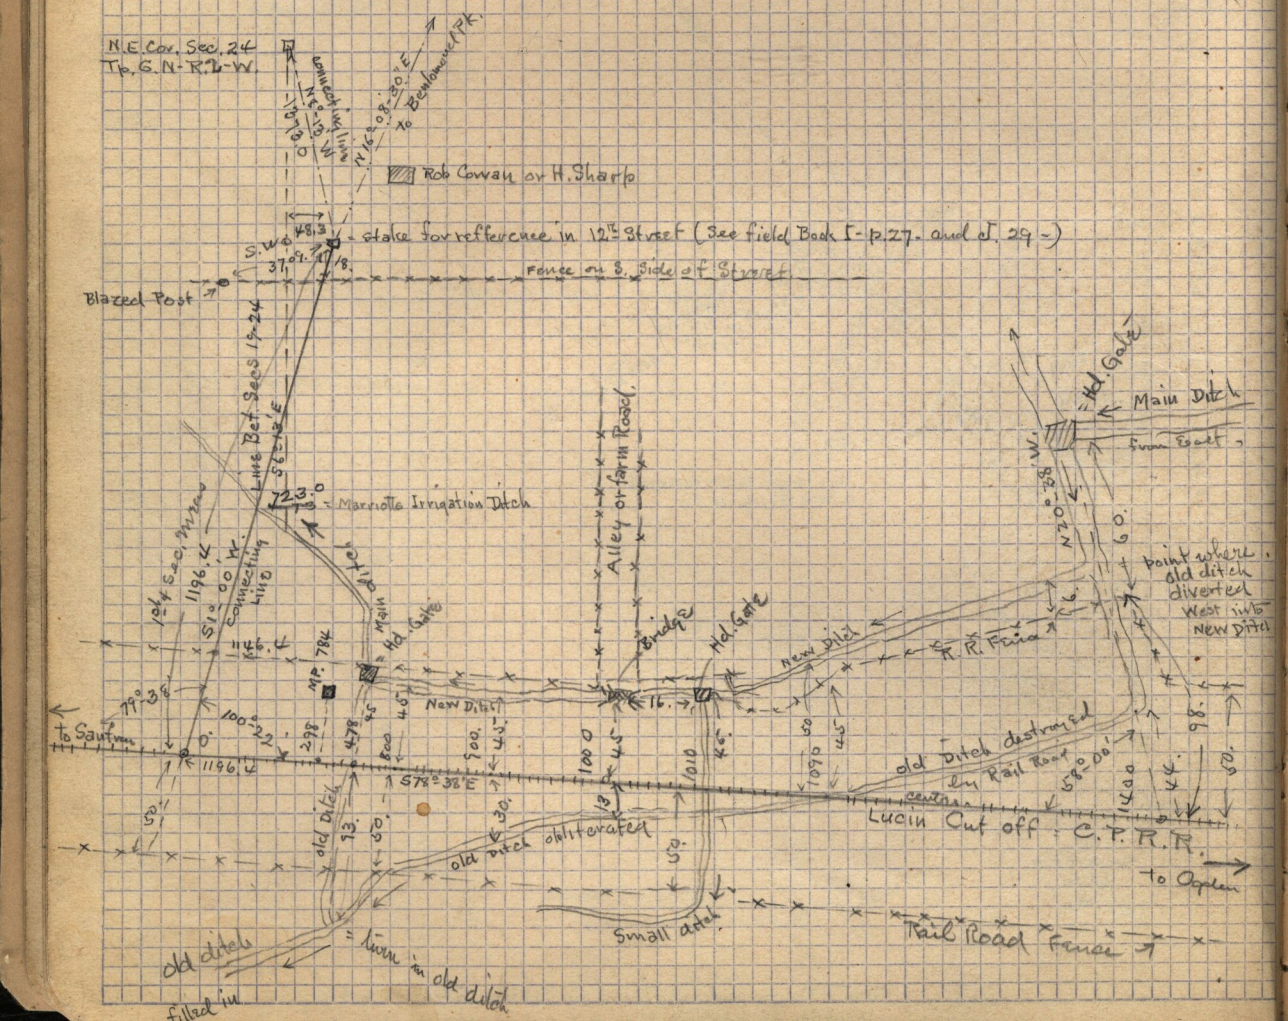
April 4 - 1905 - Survey for Marriottsville Irrigation Company.
in S.W 1/4 Sec. 19 Tp. 6 - N - R. 1. W.