March 8-06 -

(30)

T. J. Keisel

Blocks - 50-61 - Plat C. O.C-S,

160+91.70

{ Lots 4-5-6-7-10 Blk. 50 }
{ " 1-10 - " 61 }
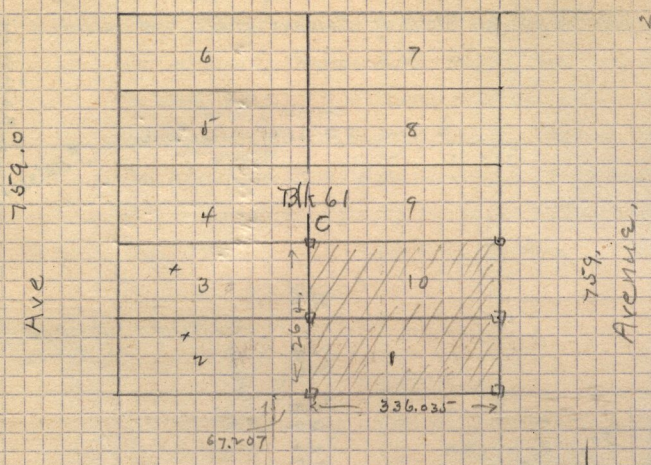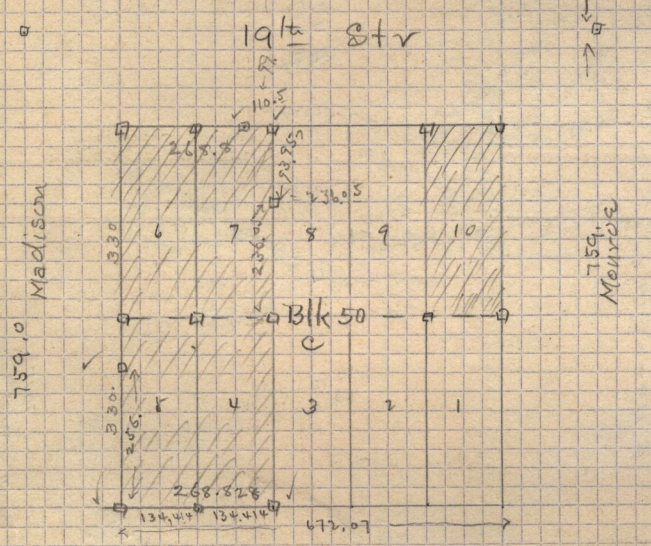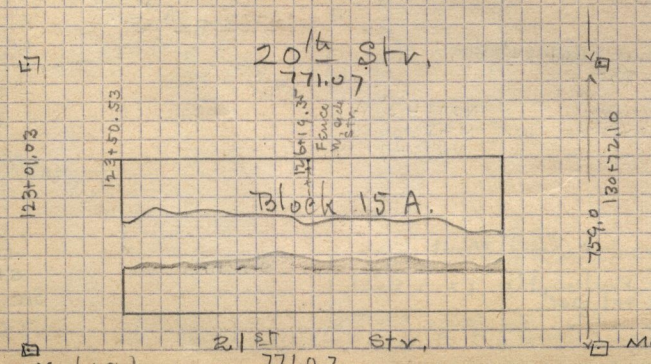
Nov. 16-1913 - Surveyed Lots 5+6-B61 - for A. Cohen