


Survey for Owens, April 16-1906. Description - Pt. Lots - Blk. 7 - Plat B - O.C.S - Bsq. 63. ft. N. of S.E. Cor. set lot - Fence N 36. ft - W 10 rods - S 26.0 ft. E 10. rods - to Cor. also Rt. of W. lsg. 7 rods, W. of N.E. cor. Block 7 - W 10. ft. S 20.5 1/2 ft - more or less to pt 63. ft. N. of S. line lot 8 - E 10. ft. N 20.5 1/2 ft. to lsg.

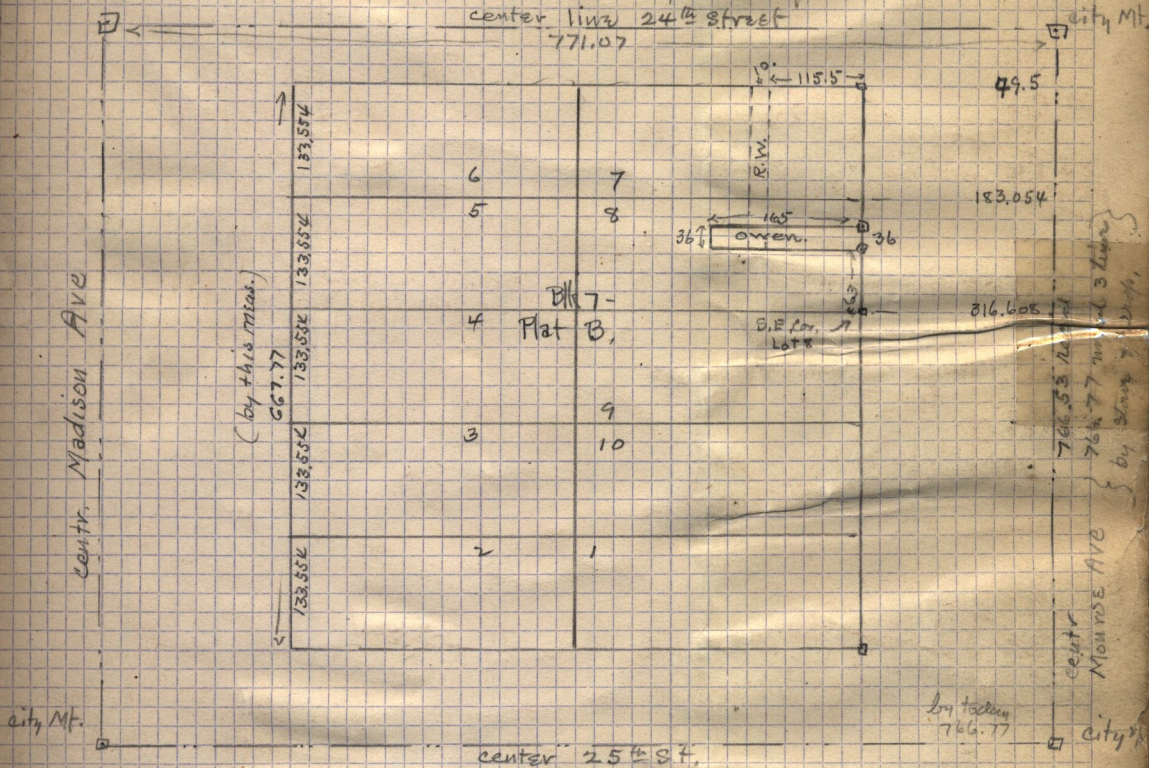

Sketch of survey.

