

(44)

Abstract - Lots 13-14 - Anita Landers Sub. Division of Lots 5-6-B28, PC


Described as follows: Beg. 33 ft. W. and 75 ft. North of S. E. Cor. Lot 5 - B28 Plat C - 1/2 Sec. 14 pt. S. 50 ft. E. 134.14 ft. to Beg.

136.00  
N. N. W. 1/4 Sec. 14


25 1/2 St. 7

761.52

25 1/2 St. 7

 

Harrison Ave  
161+20.20

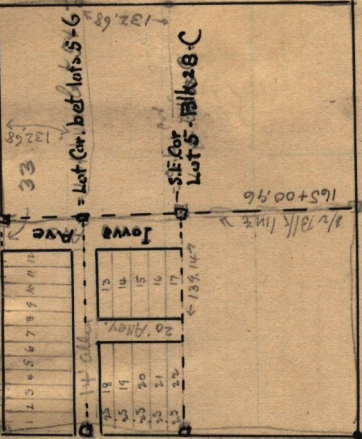

Tyler Ave  
168+81.72  
762.40

Anita Landers

26 1/2 St. 7